


301 Royal

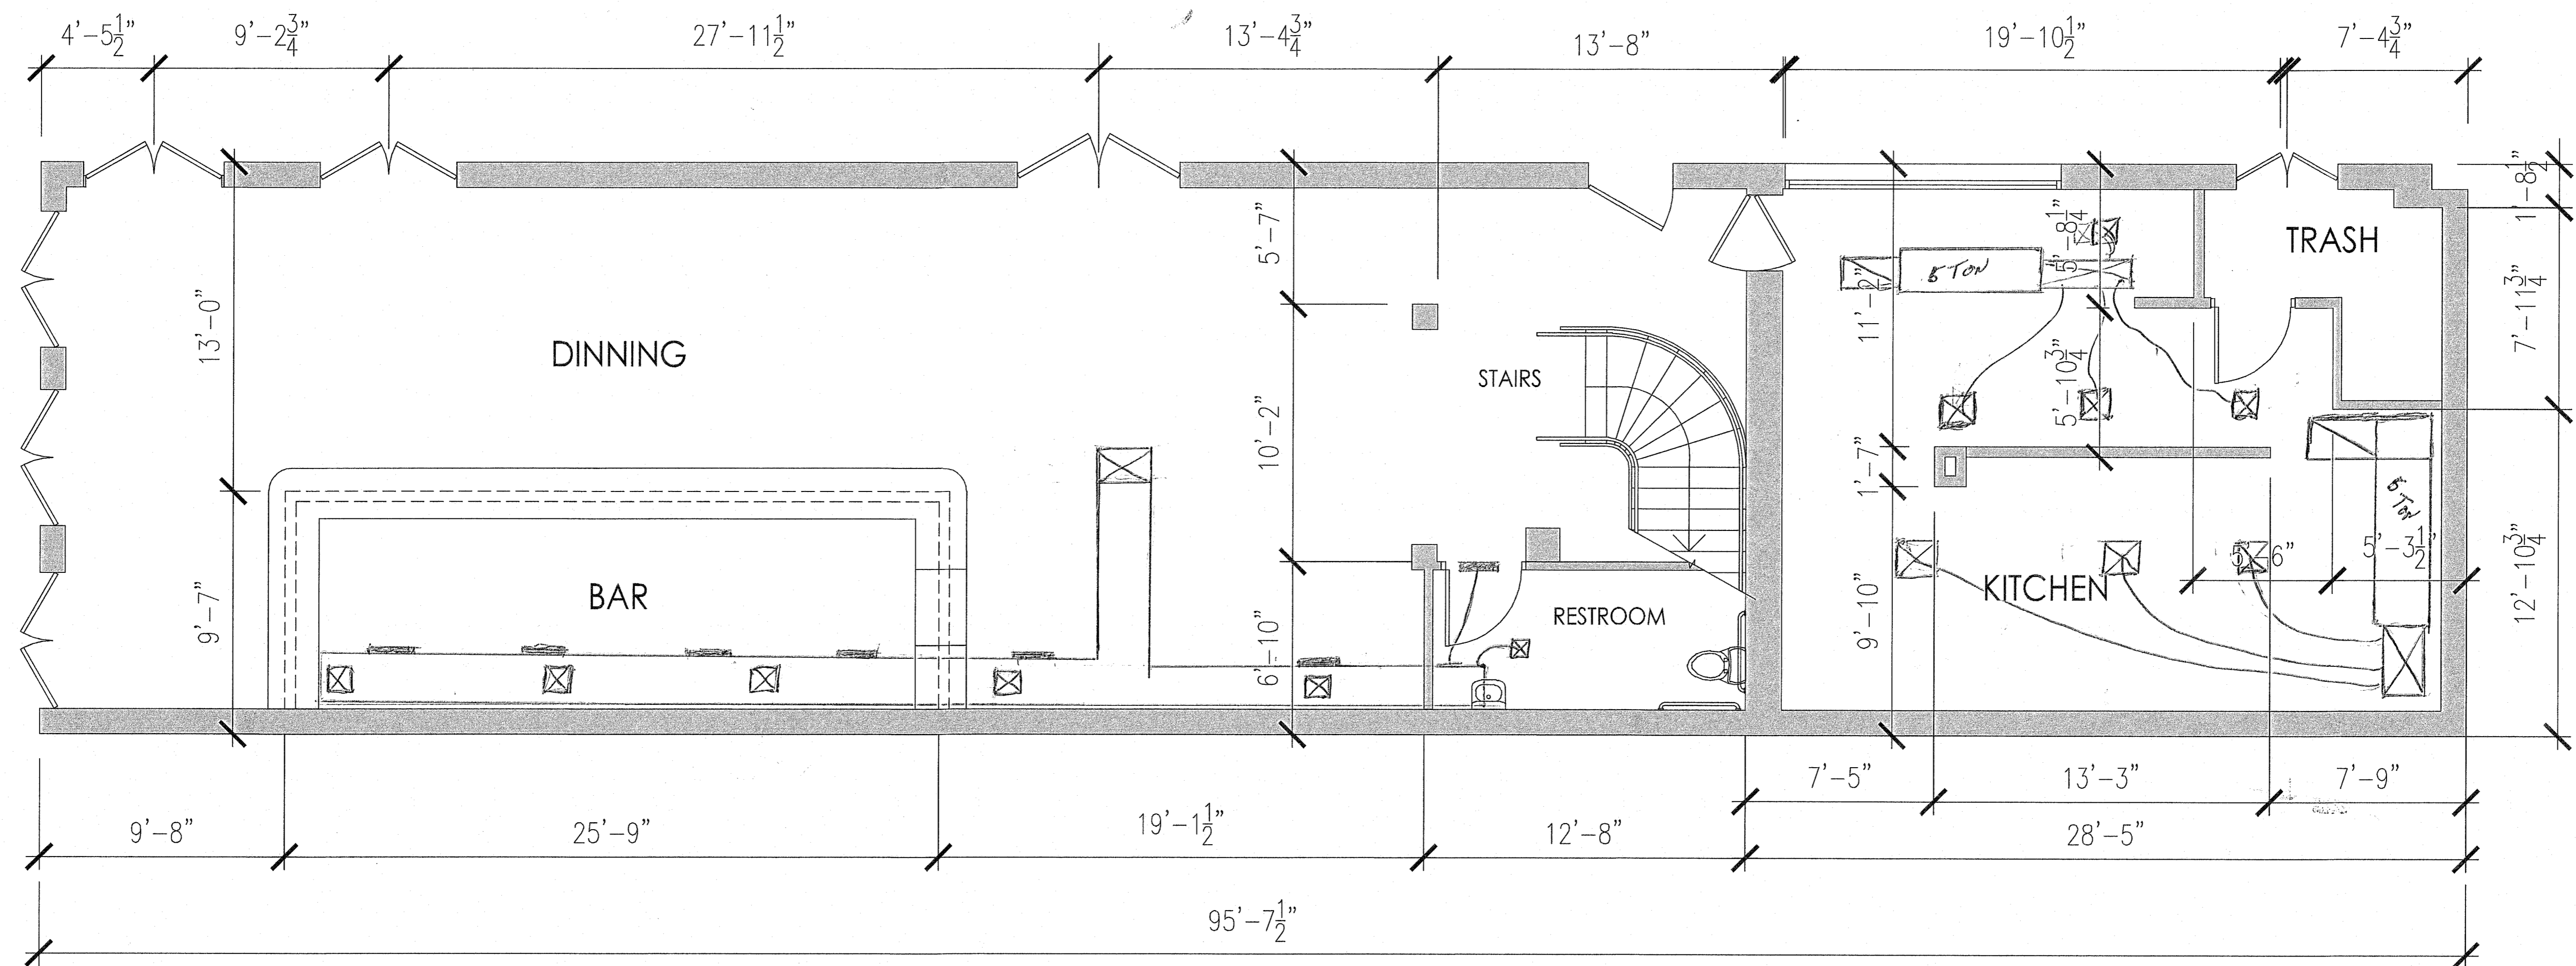

Jake Cowden-Garofalo
(504) 416-6871

301 Royal St.
Existing First Floor Plan

Scale: 3/32" = 1'-0"

NOTES: Lewis AC
Project Record

DATE:
08/16/2017

Page 1