NOTES

1. ALL DIMENSIONS ARE TO FACE OF NEW STUDS UNLESS OTHERWISE NOTED. ALL DIMENSIONS TO FACE OF WALL ARE INDICATED AS "CLEAR".
2. GREYED AND DASHED LINES REPRESENT OBJECTS THAT ARE BY OTHERS AND NOT IN CONTRACT AND ARE SHOWN FOR COORDINATION PURPOSES ONLY.
3.
4.

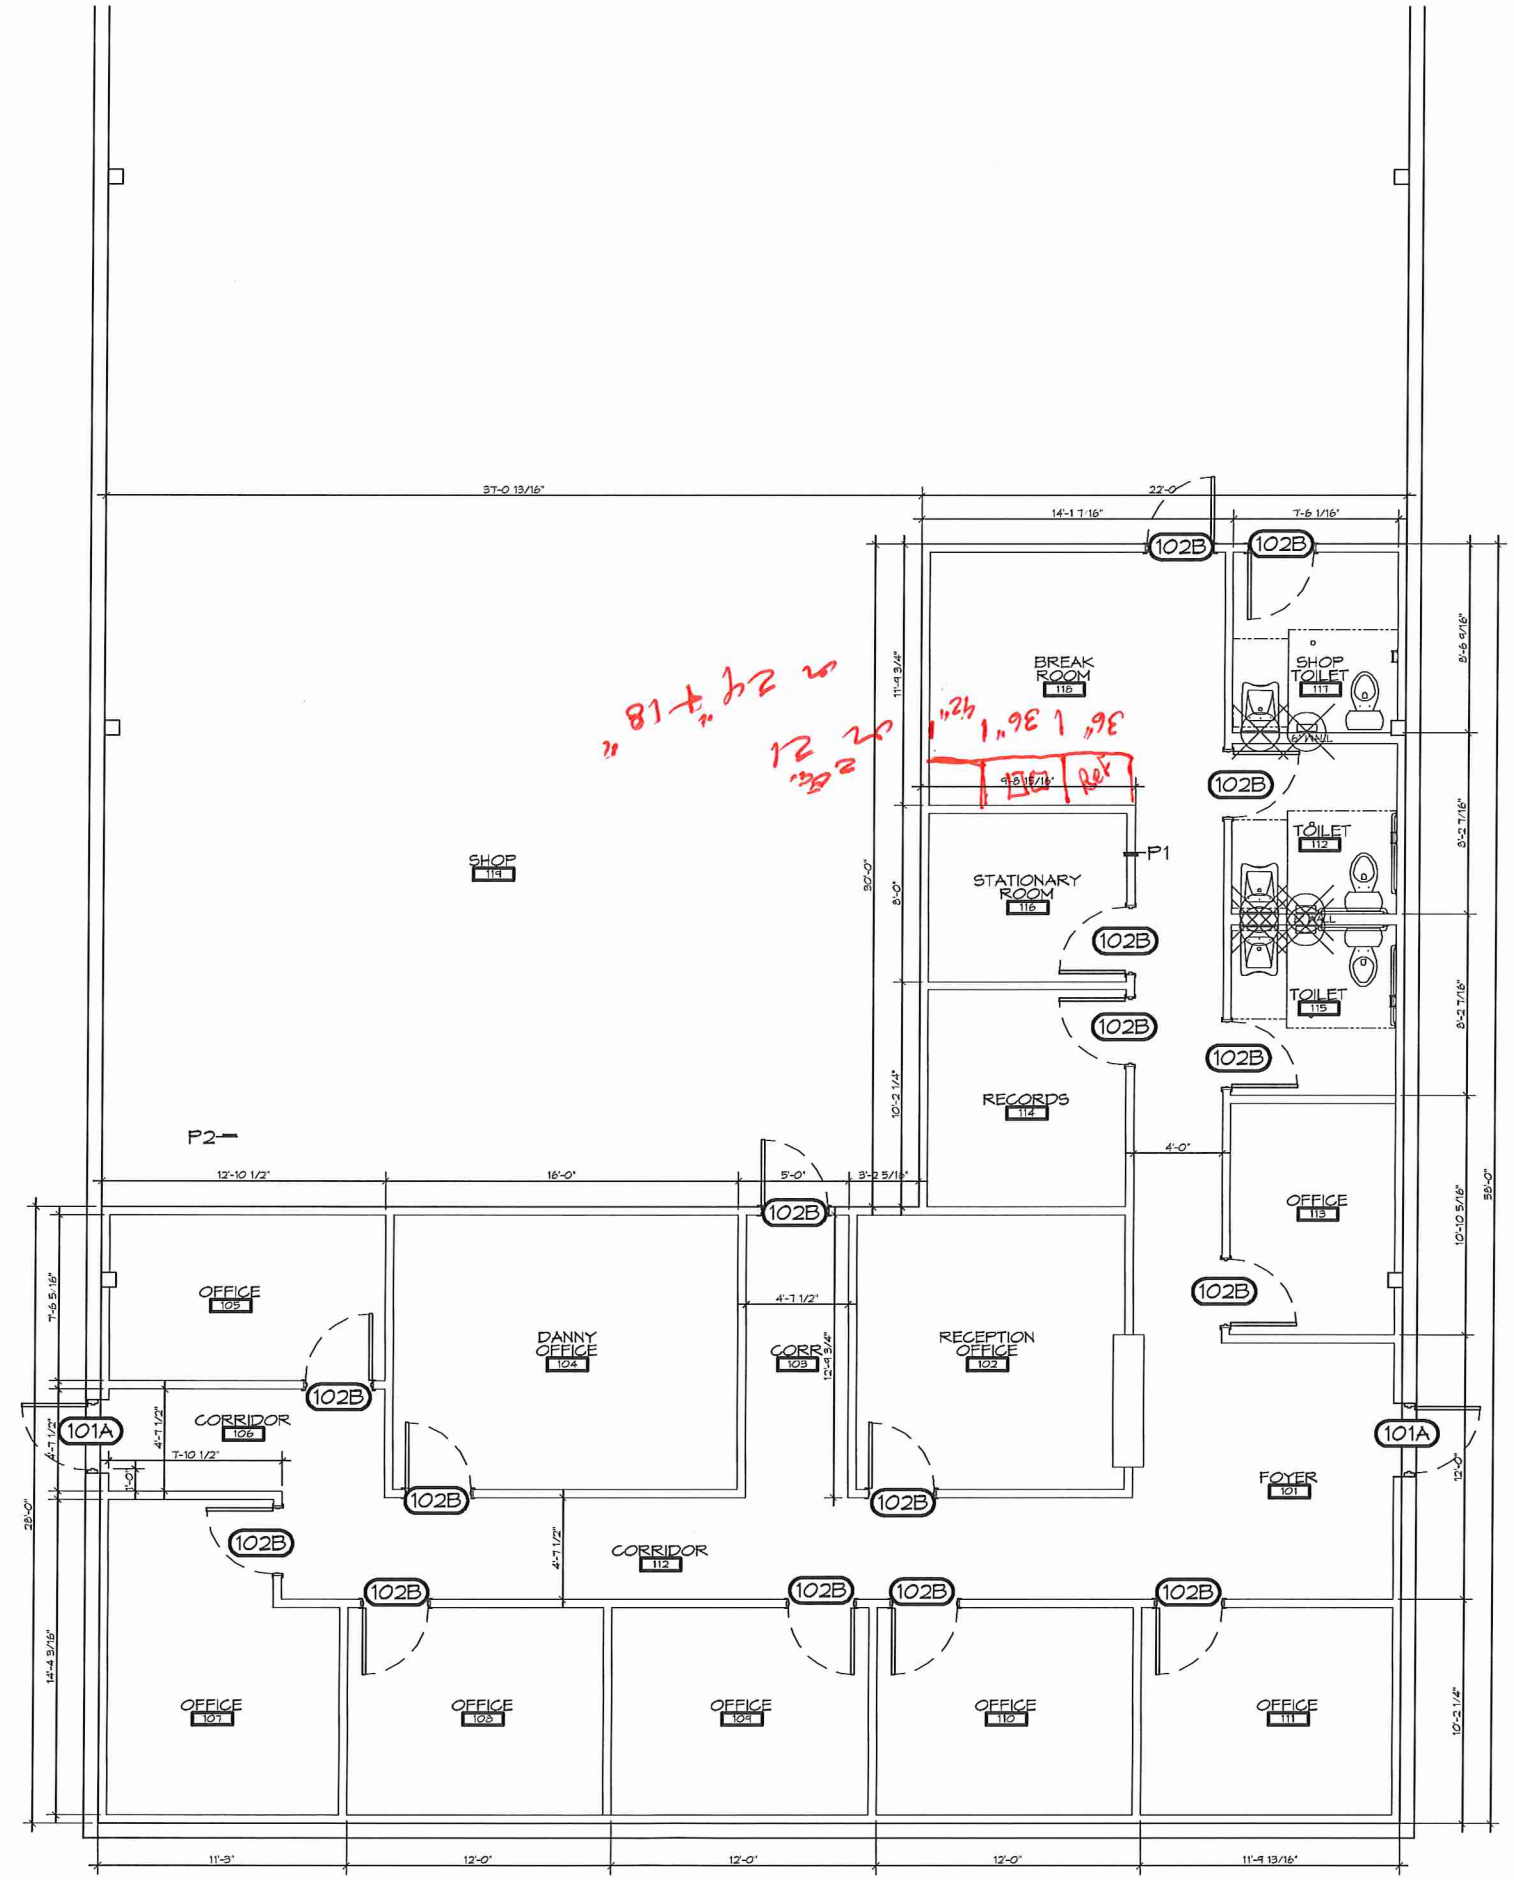

1 ARCHITECTURAL FLOOR PLAN
SCALE: 1/4" = 1'-0"

DAMMON ENGINEERING, INC.
Architects & Engineers

Chief Architect: Kevin J. Kinchen, NCARB
Chief Engineer: Brian Mistich, PE
555 Old South Trail
Slidell, LA 70458
www.dammonengineering.com
dammoneng@bellsouth.net
PH: 985.643.5833
F: 985.643.5950

#	DESCRIPTION	DATE

REVISIONS

SEAL:

PRELIMINARY NOT FOR CONSTRUCTION

NEW OFFICES:

STAN ELMORE

STONE ROAD
SLIDELL, LOUISIANA

JOB No: 2195 | DATE: 11-XX-2019
DRAWN BY: KJK | CHECKED BY: CKD

SHEET TITLE:
ARCHITECTURAL FLOOR PLAN

DRAWING NUMBER:
A1

SHEET No: 00 of XX