


ALL PROPOSED WORK DESIGNATED IN RED COLOR

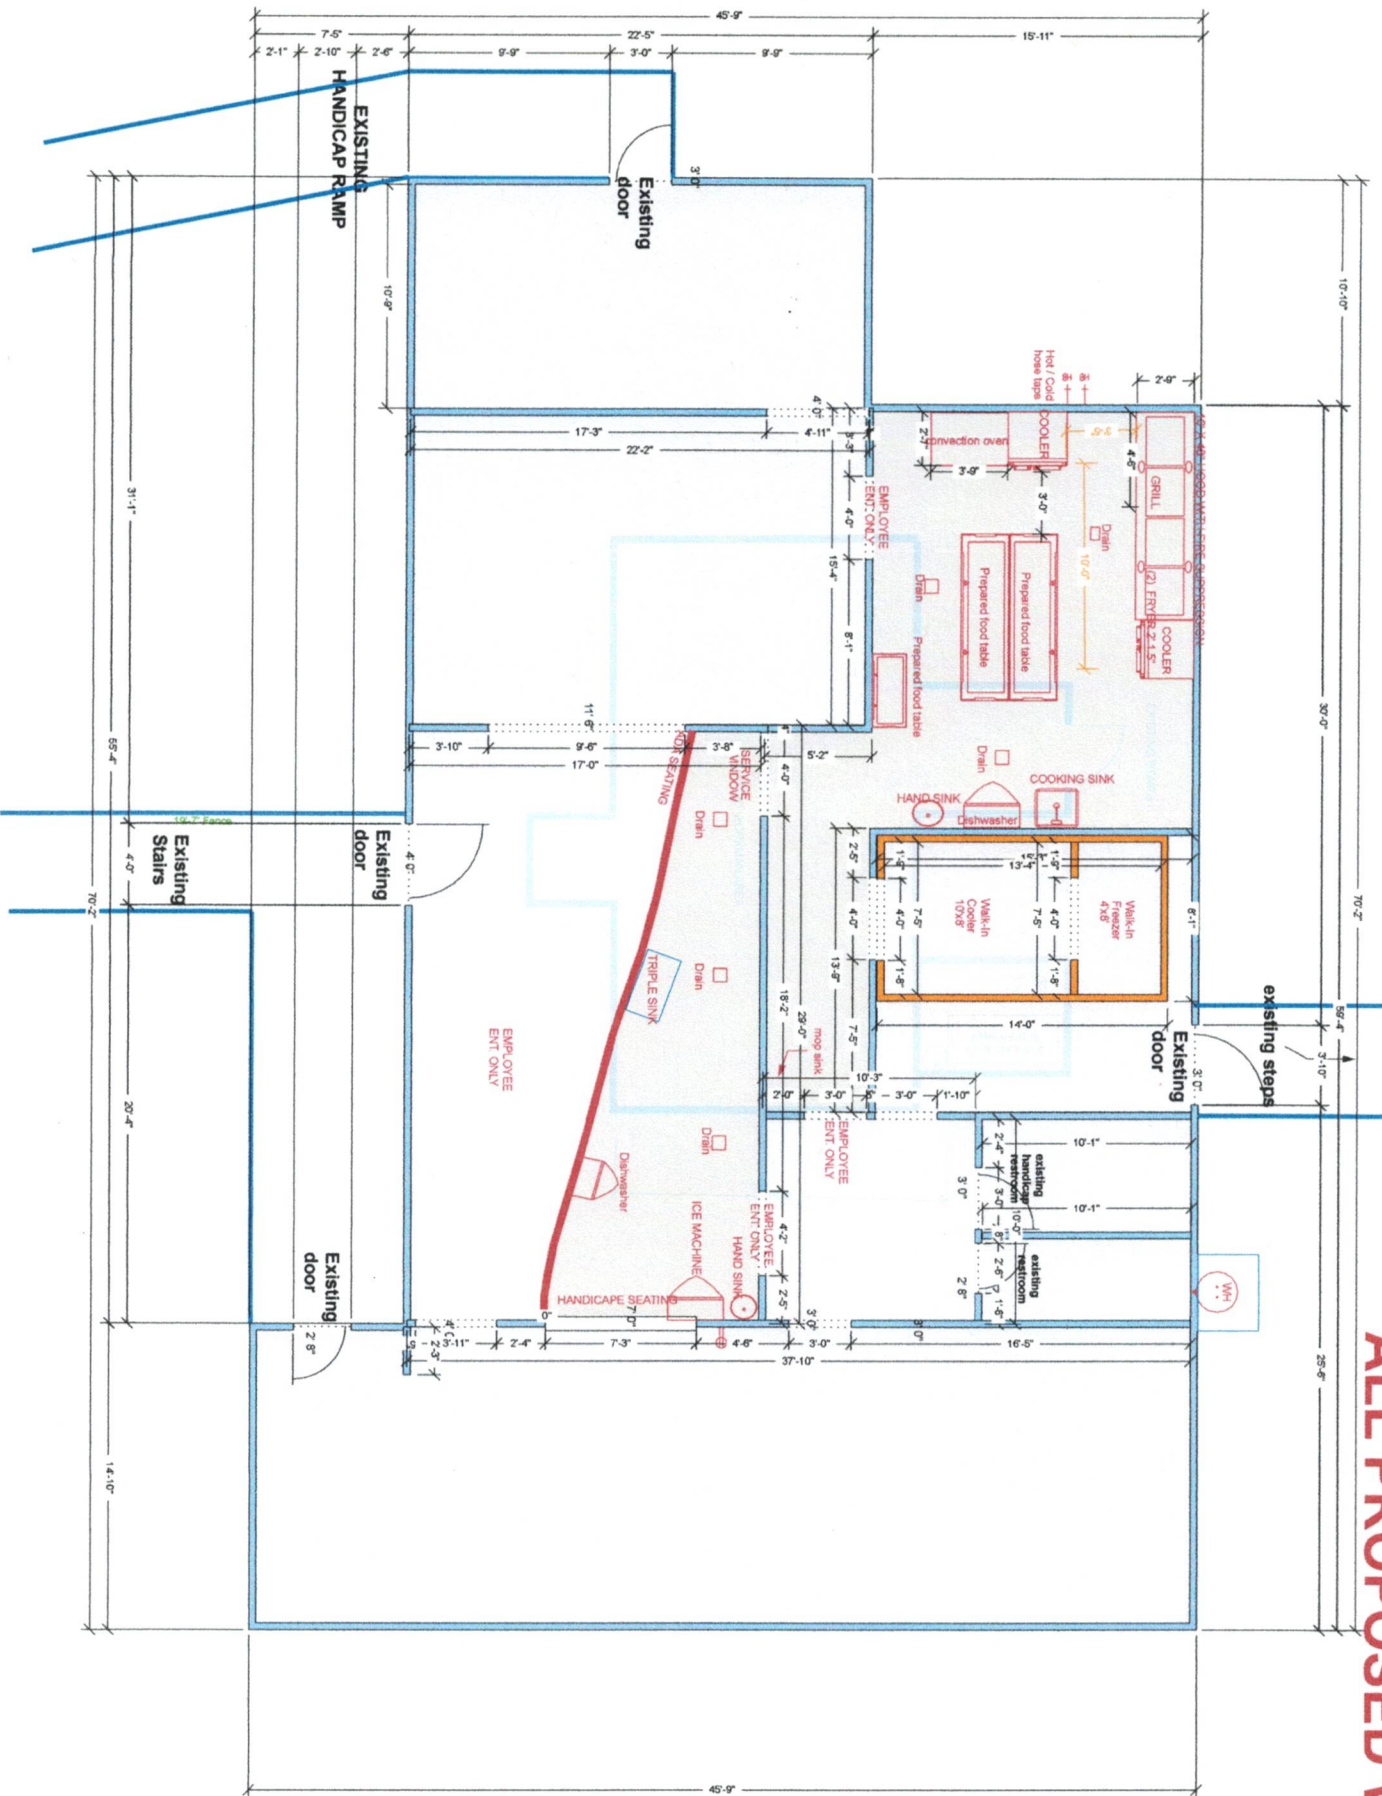

NO NEW WALLS OR ALTERATIONS OF WALLS OTHER THAN INSTALLATION OF BAR AND KITCHEN APPLIANCES

NO NEW DOORS, DOOR HARDWARE, WINDOWS

NO CHANGE IN ELEVATIONS, INTERIOR WALLS

NO WALLS TO BE MOVED OR ALTERED

NO CHANGES TO AIR CONTIONING OR HEATING SYSTEM