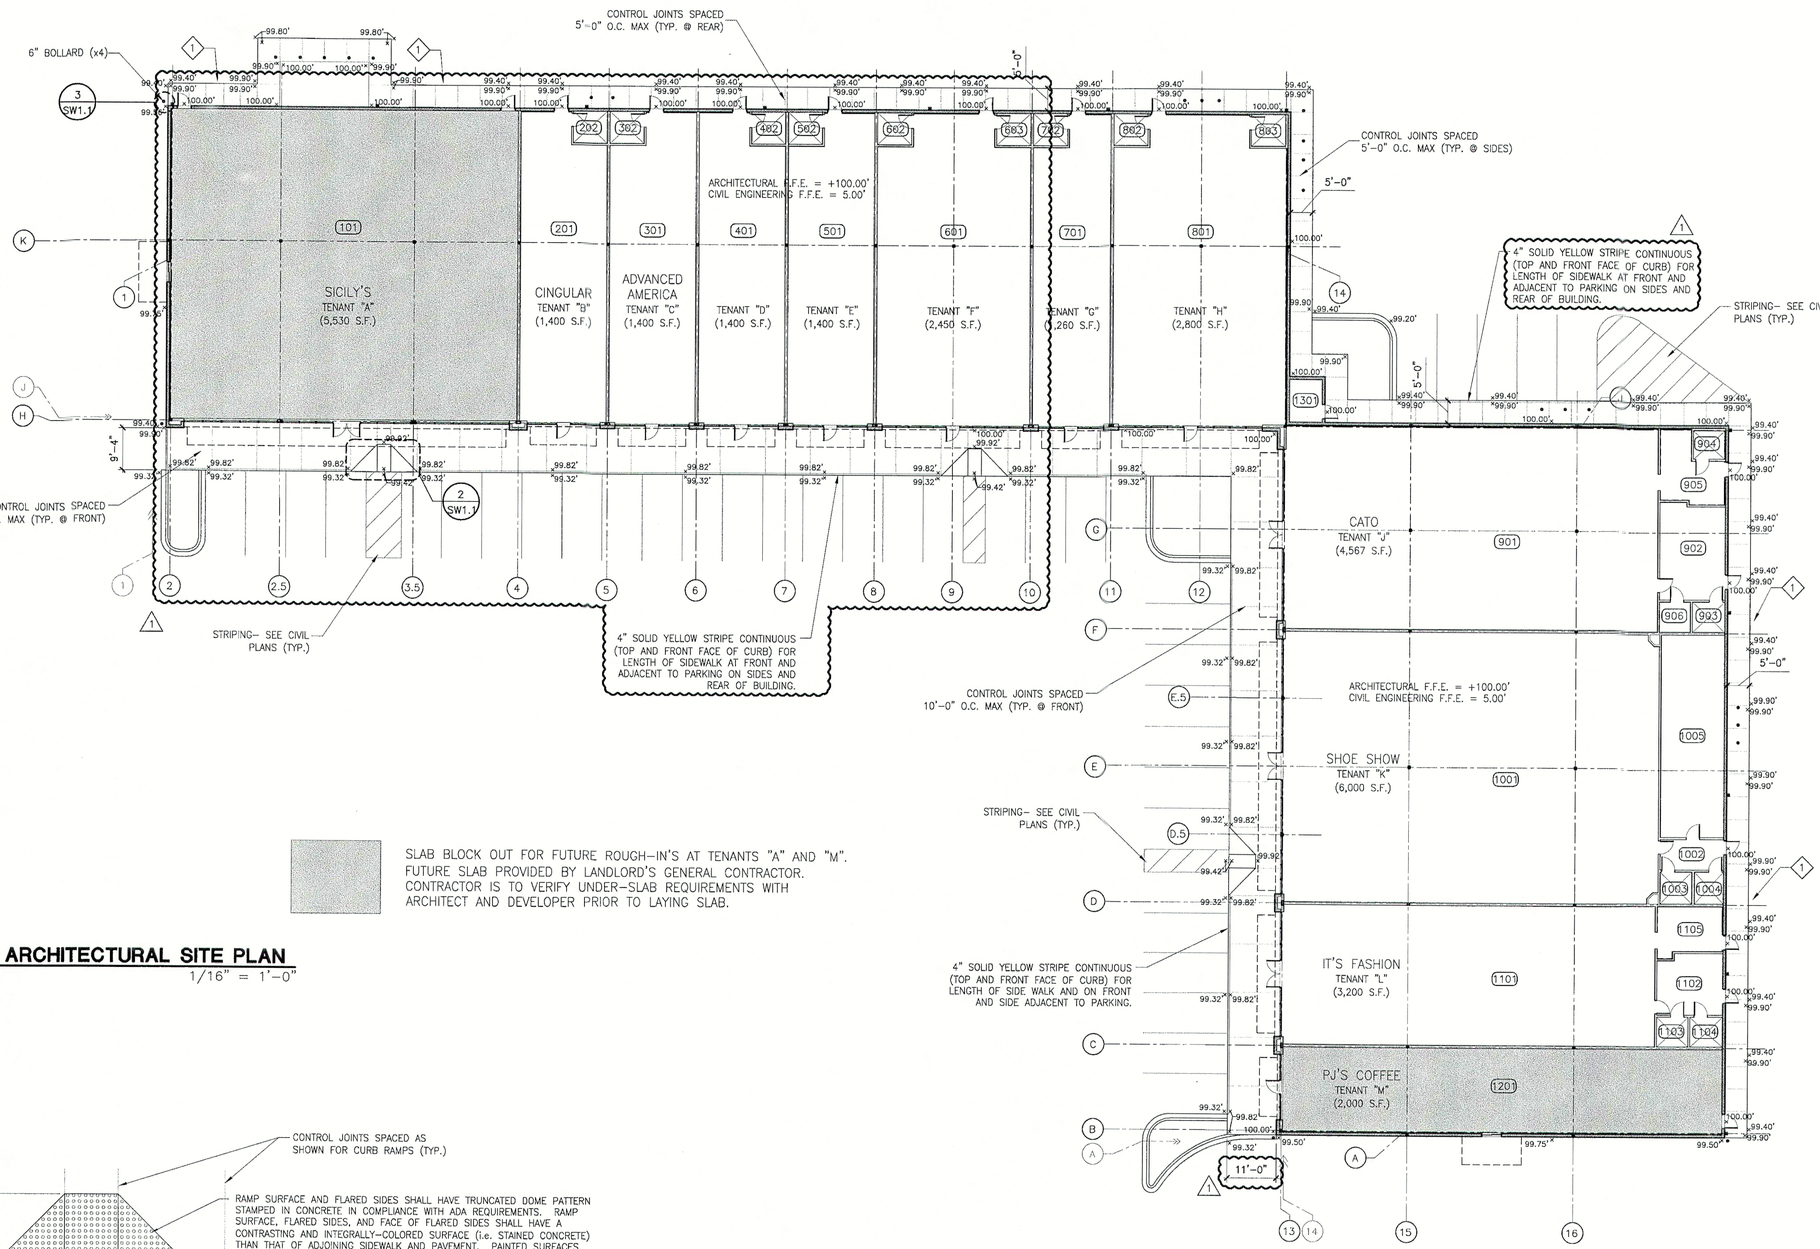

SLAB BLOCK OUT FOR FUTURE ROUGH-IN'S AT TENANTS "A" AND "M". FUTURE SLAB PROVIDED BY LANDLORD'S GENERAL CONTRACTOR. CONTRACTOR IS TO VERIFY UNDER-SLAB REQUIREMENTS WITH ARCHITECT AND DEVELOPER PRIOR TO LAYING SLAB.

1 ARCHITECTURAL SITE PLAN
1/16" = 1'-0"

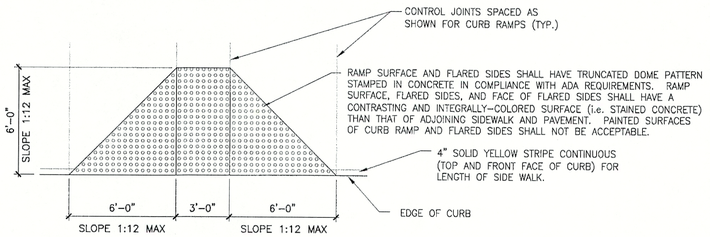

2 DETAIL
1SW1.1 1/4" = 1'-0"

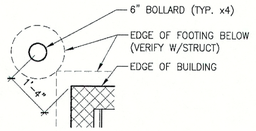

3 DETAIL
1SW1.1 1/2" = 1'-0"

4 GENERAL NOTES

1. PROVIDE 16 SLOT U.S. POSTAL SERVICE APPROVED OUTDOOR CENTRALIZED MAIL DELIVERY SYSTEM. SEE CIVIL PLANS FOR LOCATION.

   AMERICAN POSTAL MFG. (877) 244-5618

   MODEL # N1004638 ALUMINUM

5 SPECIFIC NOTES

1. CONTRACTOR TO SLOPE PAVEMENT TO CREATE 6" CURB IN 10' (SEE CIVIL).

DATE	REV #1	BY
9/17/07	DESCRIPTION	LMR

REVISION

DDG DUPLANTIS DESIGN GROUP, PC
Respect • Integrity • Client Satisfaction • Excellence
THIBODAUX MANDEVILLE HOUSTON
Civil Engineering • Site Development • Land Planning • Public Works • Architecture
314 East Bayou Road
Thibodaux, Louisiana 70301
Phone: 985.447.5000
Fax: 985.447.5009

STAMP: STEPHEN M. VIGUERIE, No. 5171, STATE OF LOUISIANA, REGISTERED ARCHITECT

SIGNATURE:

DATE: 9/17/07

PROPOSED RETAIL DEVELOPMENT
CITY OF BOUTTE
ST. CHARLES PARISH, LOUISIANA

FOR THE SPECTRA GROUP, INC.
MEMPHIS, TENNESSEE

DRAWN	LMR
CHECKED	SMV
DATE	8/13/07
SCALE	AS NOTED ON DWG
PROJECT NO.	07-205A
FILE:	REVISION 1\SW1-1.DWG
SHEET	SW1.1