


SHOE SHOW  
TENANT "K"  
(6,000 S.F.)  
(100)

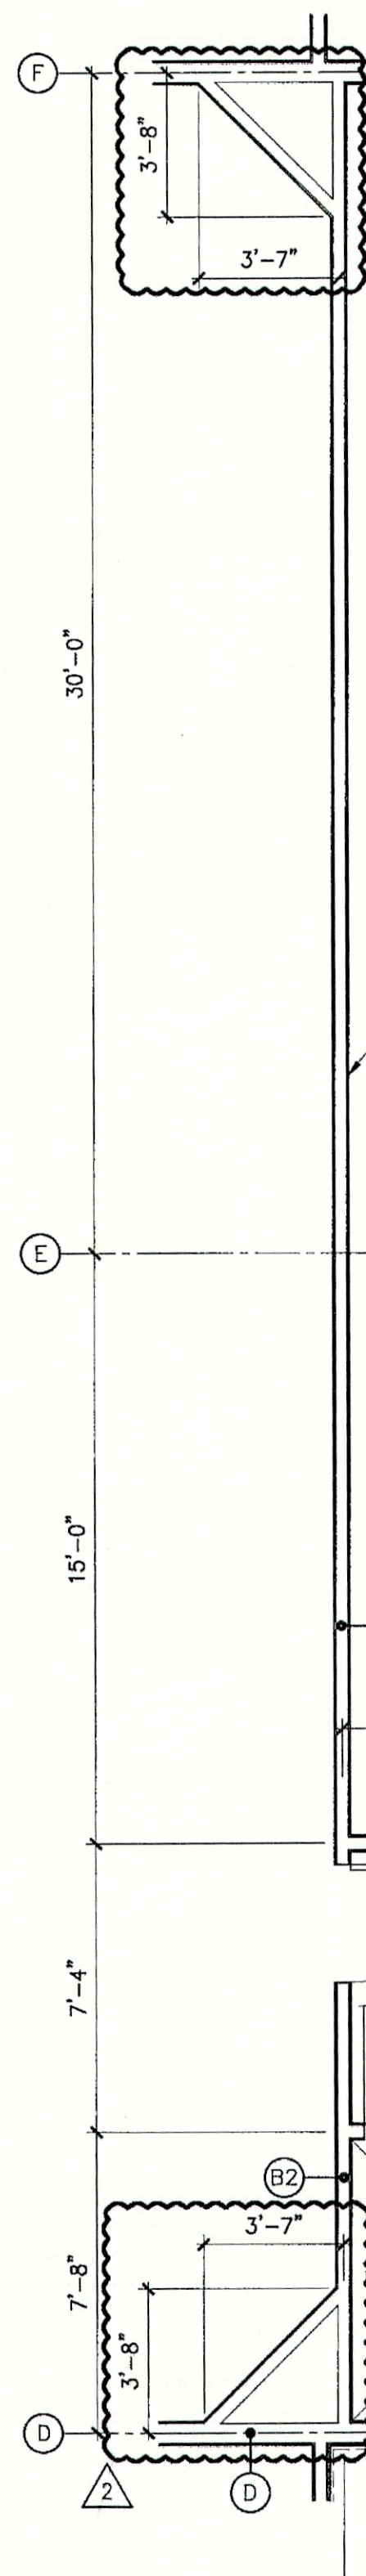

**1 ENLARGED PLAN**  
1A1.1 CATO 1/4" = 1'-0"

**2 ENLARGED PLAN**  
1A1.1 SHOE