


**1 ENLARGED PLAN**  
1A1.1 CATO 1/4" = 1'-0"

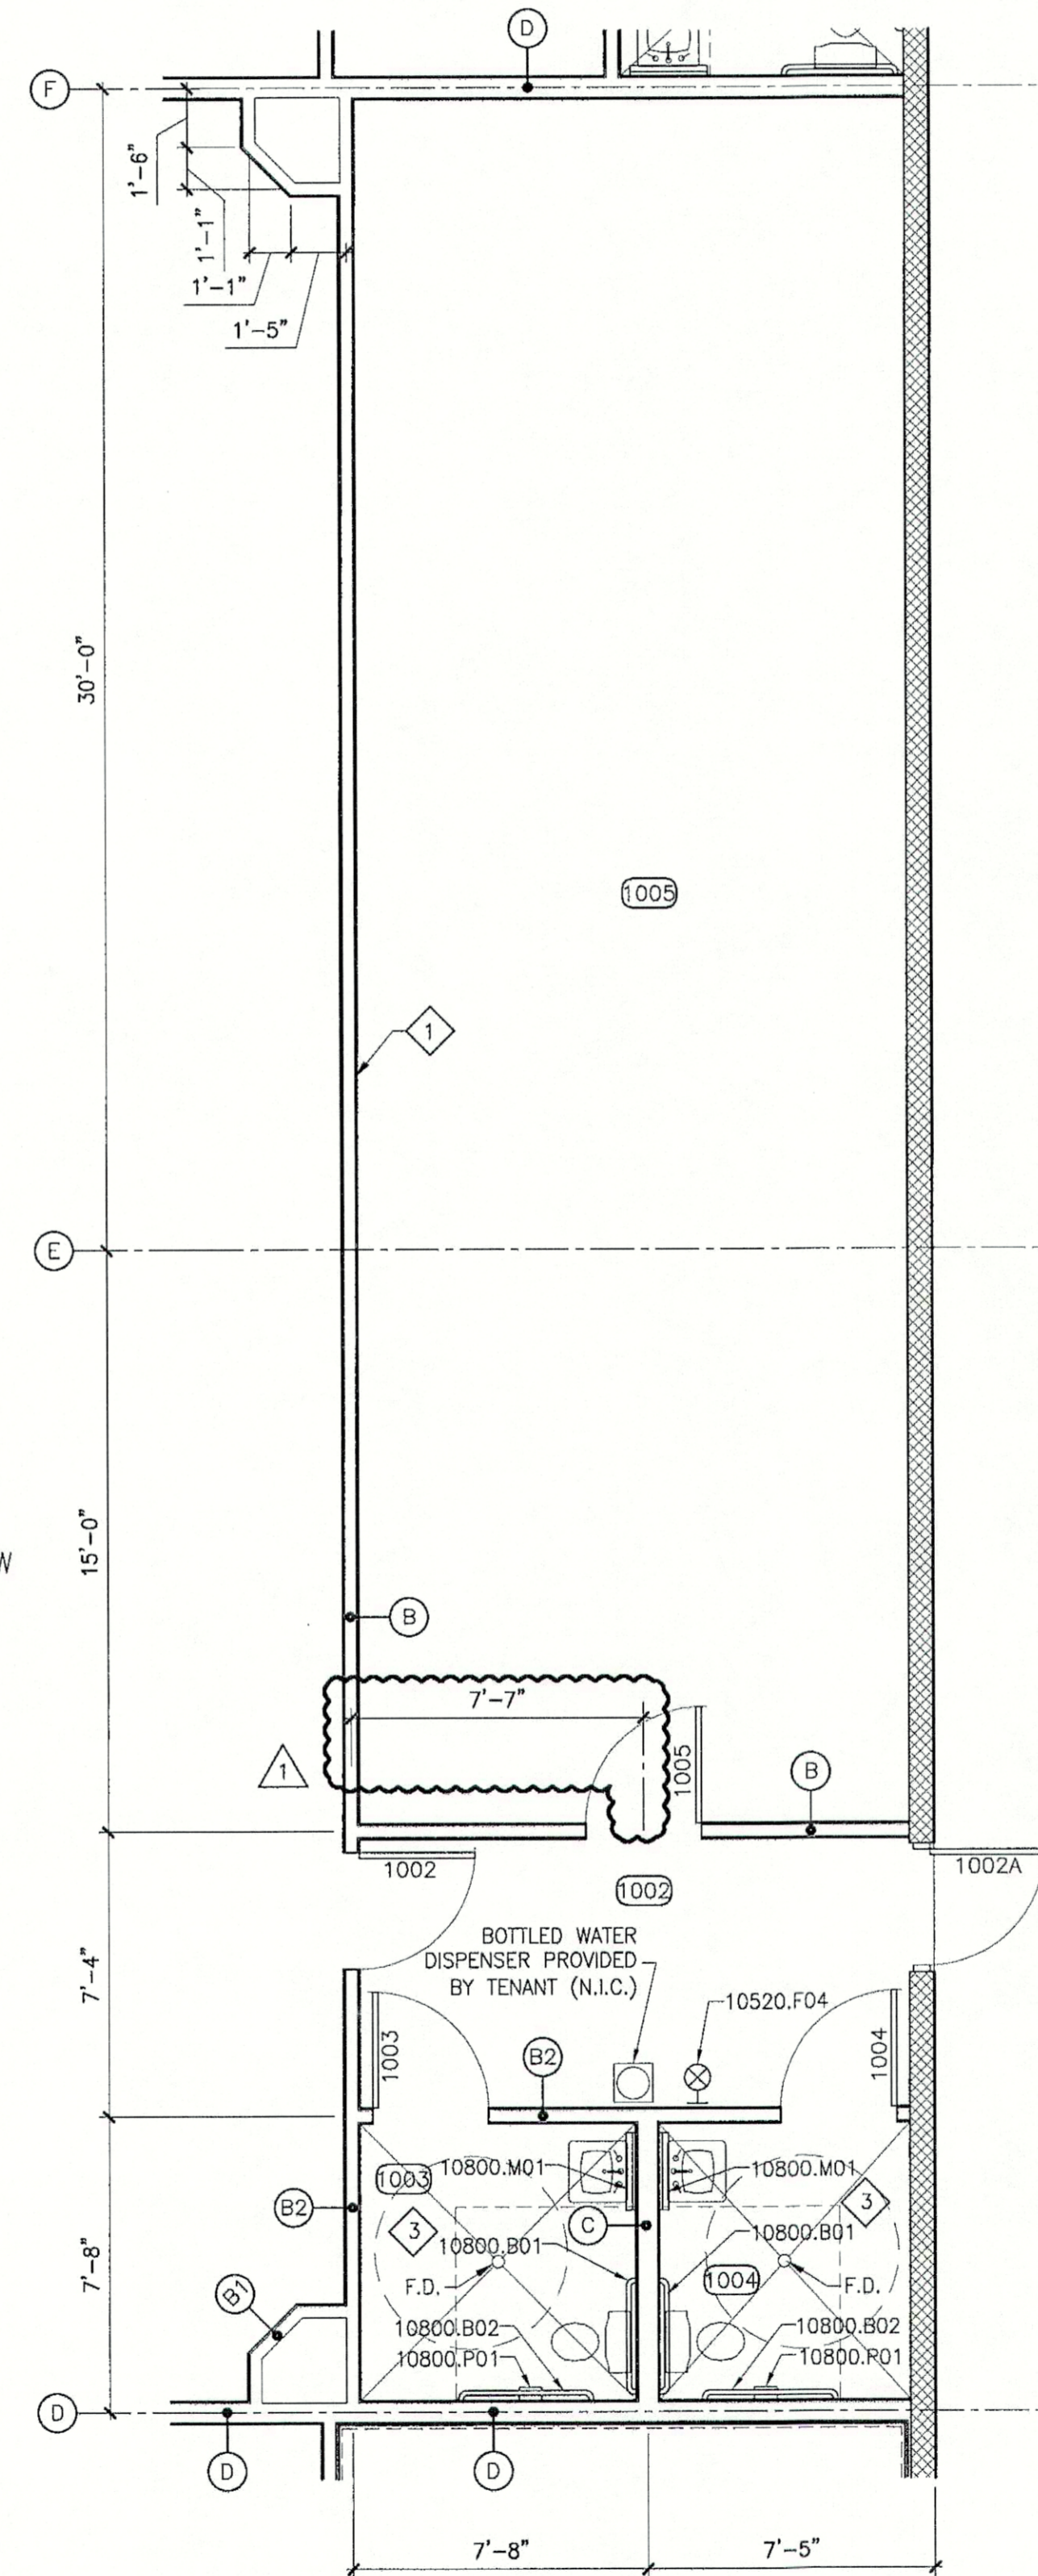

**2 ENLARGED PLAN**  
1A1.1 SHOE SHOW 1/4" = 1'-0"

3	KEYNOTES
10520.F04	FIRE EXT. W/WALL HOOK
10800.B01	38" x 1-1/4" DIA GRAB BAR
10800.B02	42" x 1-1/4" DIA GRAB BAR
10800.M01	MIRROR: 24" x 36"; FRAMED, WITH SHELF
10800.P01	TOILET PAPER HOLDER

4	SPECIFIC NOTES
1	INTERIOR WALLS IN FITTING ROOMS (NOTED) TO RECEIVE 3/8" OSB PLYWOOD FLOOR TO CEILING ON FITTING ROOM SIDE BETWEEN STUDS AND DRYWALL TYPICAL CONTINUOUS IN LOCATIONS NOTED. FURR WITH 7/8" HAT CHANNELS AT CMU WALLS.
2	FIRST CRITICAL STUD TO BEGIN 2'-2" FROM CORNER OF WALL. ALL FOLLOWING STUDS TO BE ON 24" CENTERS. SHEETS OF GWB MUST RUN VERTICALLY NOT HORIZONTALLY.
3	2% MAX. SLOPE FOR RESTROOM FLOOR DRAINAGE.

5	GENERAL NOTES
1.	BOTTLED WATER DISPENSER PROVIDED BY TENANT. (N.I.C.)
2.	INSTALL 5/8" GYP. BD. ON 2" METAL HAT CHANNEL @ 16" O.C. WITH 1 1/2" RIGID INSULATION ON ALL MASONRY WALLS.
3.	EXTEND GYP. BD. TO METAL DECK IN ALL AREAS WITHOUT CEILINGS. IN AREAS WITH CEILINGS INSTALL GYP. BD. 6" ABOVE CEILING HEIGHT.

DATE	DESCRIPTION	BY
9/17/07	REVISION	LMR

**DDG DUPLANTIS DESIGN GROUP, PC**  
 Respect • Integrity • Client Satisfaction • Excellence  
 THIBODAUX • MANDEVILLE • HOUSTON  
 Civil Engineering • Site Development • Land Planning • Public Works • Professional Services  
 314 East Bay Road  
 Thibodaux, Louisiana 70301  
 Phone: 985.447.0380  
 Fax: 985.447.7039

STAMP  
  
 SIGNATURE: *[Signature]*  
 DATE: 9/17/07

PROPOSED RETAIL DEVELOPMENT  
 CITY OF BOULTE  
 ST. CHARLES PARISH, LOUISIANA  
 FOR THE SPECTRA GROUP, INC.  
 MEMPHIS, TENNESSEE

DRAWN: LMR  
 CHECKED: SMV  
 DATE: 8/13/07  
 SCALE: AS NOTED ON DWG  
 PROJECT NO.: 07-205A  
 FILE: REVISION 1\A1-3.DWG  
 SHEET: **A1.3**