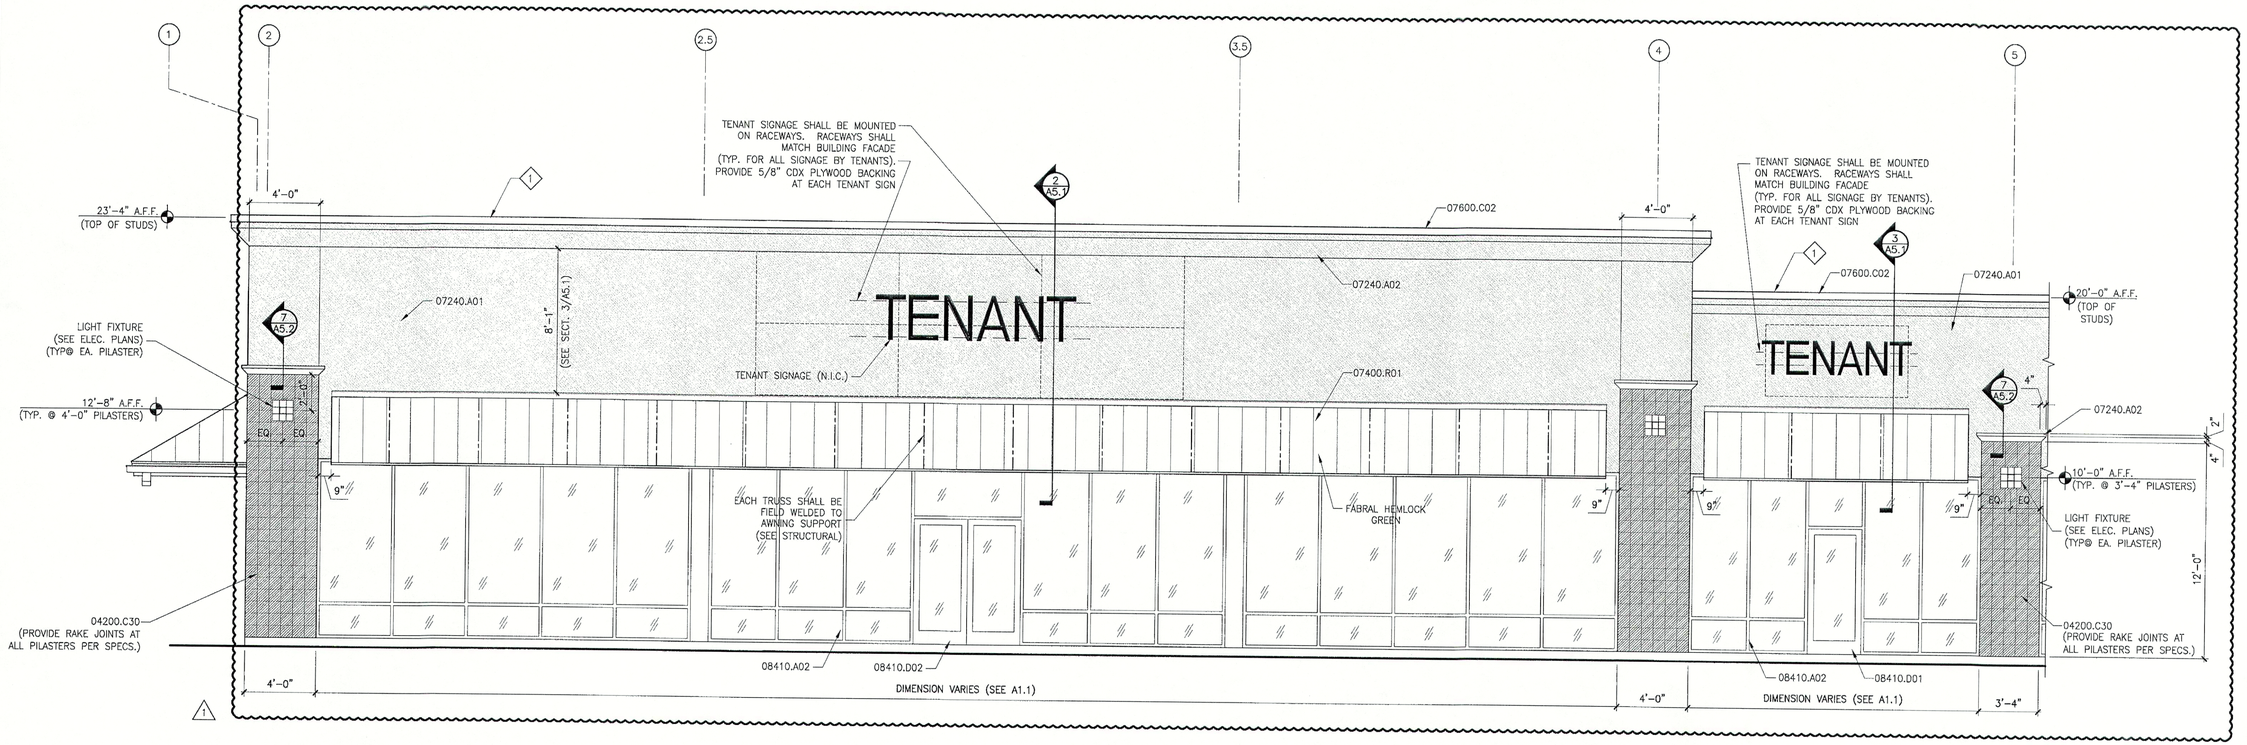


**1 DETAIL** (1A4.1)
1/4" = 1'-0"

## 2 GENERAL NOTES

1. PAINT ALL EXPOSED MATERIALS INCLUDING BUT NOT LIMITED TO GAS PIPING, COPPER PIPING, CONDUIT, UNISTRUT, MISC. SUPPORTS, ETC.

## 3 KEYNOTES

| | |
|---|---|
| 04200.C30 | 8 x 8 x 16 C.M.U., SMOOTH FACED, SCORED, RUNNING BOND |
| 07240.A01 | E.I.F.S. OVER INSULATION BOARD, SEE DETAILS |
| 07240.A02 | E.I.F.S. ACCENT BAND |
| 07600.C02 | 24 GA. PREFIN. METAL COPING |
| 08410.A02 | ALUM. STOREFRONT FRAMING COMPONENT |
| 08410.D01 | ALUM. STOREFRONT DOOR |

## 4 PAINT SCHEDULE

- BENJAMIN MOORE GRANT BEIGE HC-83
- BENJAMIN MOORE HUNTINGTON BEIGE HC-21
- FABRAL BONE WHITE
- METAL AWNING FABRAL – HEMLOCK GREEN

## 5 SPECIFIC NOTES

1. EXPOSED FASTENERS WILL ONLY BE ALLOWED WITH PRIOR APPROVAL OF OWNER.

| DATE | DESCRIPTION | BY |
|---|---|---|
| 9/17/07 | REV #1 | LMR |

**REVISION**


DDG DUPLANTIS DESIGN GROUP, PC
Respect • Integrity • Client Satisfaction • Excellence
THIBODAUX MANDEVILLE HOUSTON
Civil Engineering • Site Development • Land Planning • Public Works • Architecture
314 East Bayou Road, Suite 1
Thibodaux, Louisiana 70301
Phone: 985.447.7002
Fax: 985.447.7009


SIGNATURE: Stephen M. Vigneri
DATE: 9/17/07
STAMP: STEPHEN M. VIGNERIE ★ NO. 5142 ★ STATE OF LOUISIANA ★ REGISTERED ARCHITECT

**PROPOSED RETAIL DEVELOPMENT**
**CITY OF BOUTTE**
**ST. CHARLES PARISH, LOUISIANA**

**FOR THE SPECTRA GROUP, INC.**
**MEMPHIS, TENNESSEE**

| | |
|---|---|
| DRAWN | LMR |
| CHECKED | SMV |
| DATE | 8/13/07 |
| SCALE | AS NOTED ON DWG |
| PROJECT NO. | 07-205A |
| FILE: | REVISION 1\A4-2.DWG |
| SHEET | ~~A4.2~~ |