


DATE	DESCRIPTION	BY	REVISION
6/5/06	REV #1	CJC	
2/26/08	REV #2	LMR	
9/17/07	REV #1	LMR	

DDG DUPLANTIS
DDG DESIGN GROUP, PC
 Respect • Integrity • Client Satisfaction • Excellence
 THIODOUX, MANDEVILLE, HOUSTON
 Civil Engineering • Site Development • Land Planning • Public Works • Architecture
 314 East Bayou Road • Phone: 985.447.0090
 Thibodaux, Louisiana 70301 • Fax: 985.447.7009

STAMP
 M. VIGORIE
 REGISTERED PROFESSIONAL ENGINEER
 STATE OF LOUISIANA
 No. 5117
 EXP. 12/31/08
 SIGNATURE: [Signature]
 DATE: 6/5/08

PROPOSED RETAIL DEVELOPMENT
 CITY OF BOUTTE
 ST. CHARLES PARISH, LOUISIANA
 FOR THE SPECTRA GROUP, INC.
 MEMPHIS, TENNESSEE

DRAWN	LMR
CHECKED	SMV
DATE	8/13/07
SCALE	AS NOTED ON DWG
PROJECT NO.	07-205A
FILE:	REVISION 3\A6-1.DWG
SHEET	A6.1

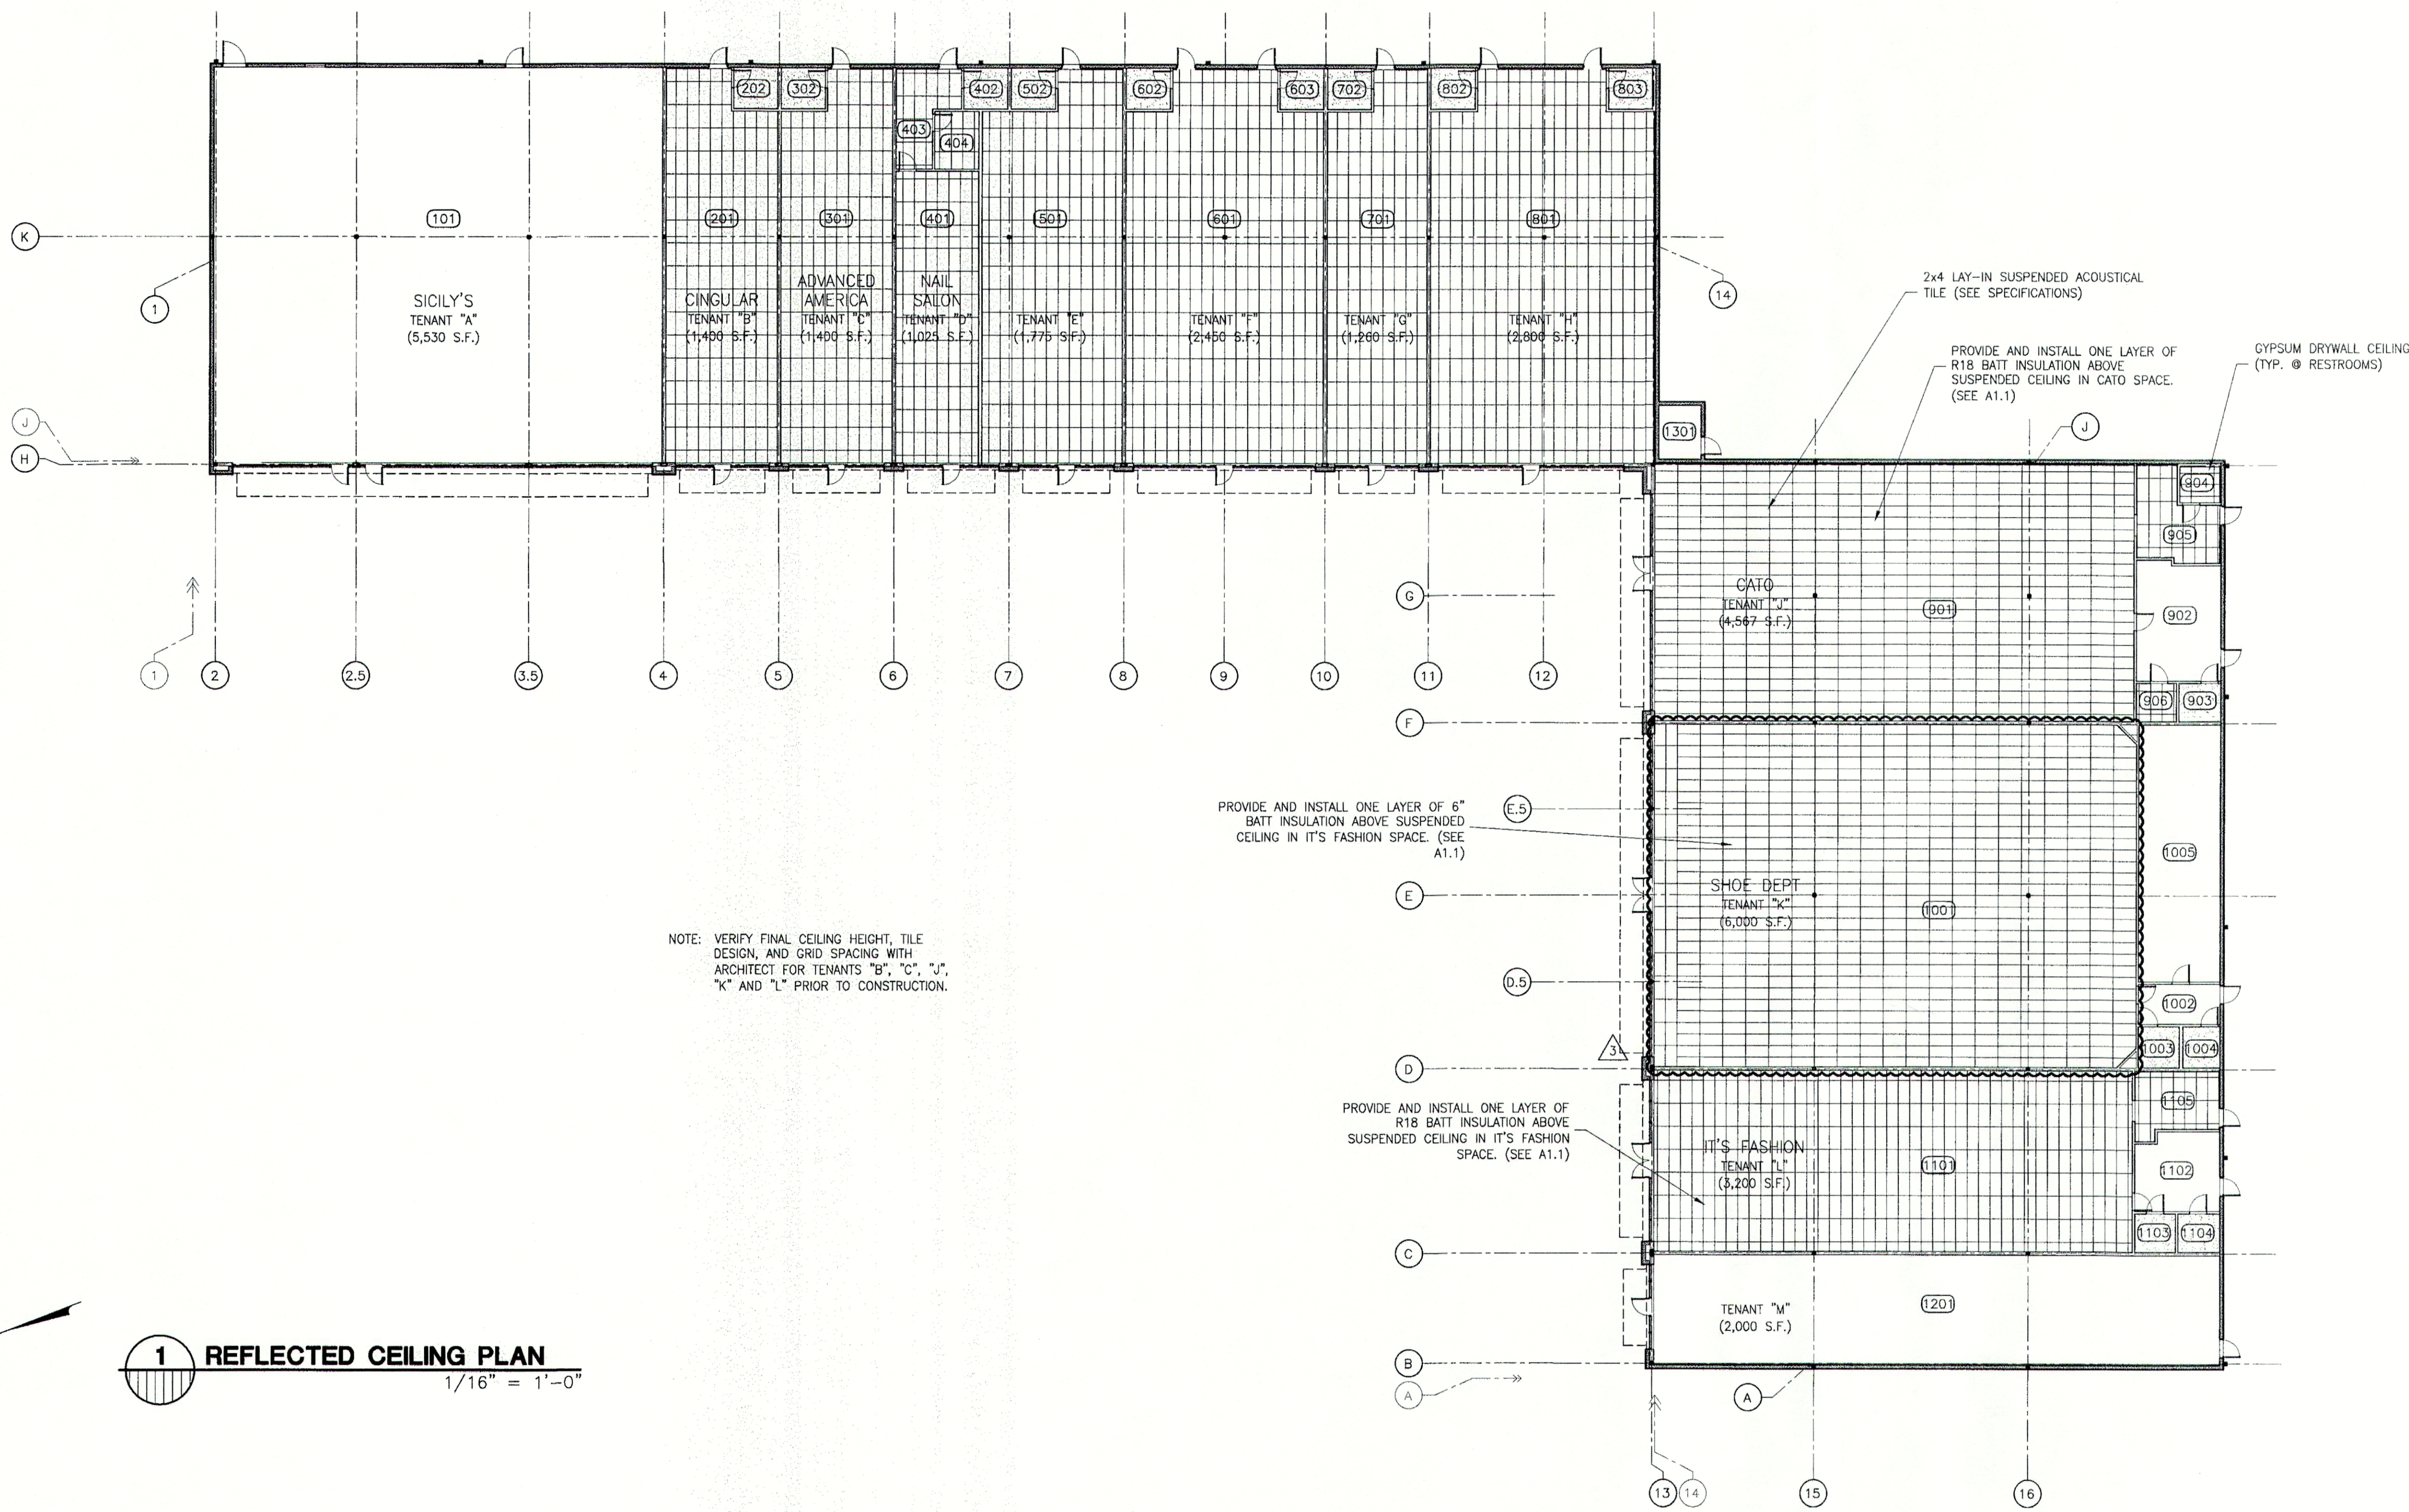

1 REFLECTED CEILING PLAN
 1/16" = 1'-0"

NOTE: VERIFY FINAL CEILING HEIGHT, TILE DESIGN, AND GRID SPACING WITH ARCHITECT FOR TENANTS "B", "C", "J", "K" AND "L" PRIOR TO CONSTRUCTION.