



1 STOREFRONT TYPES

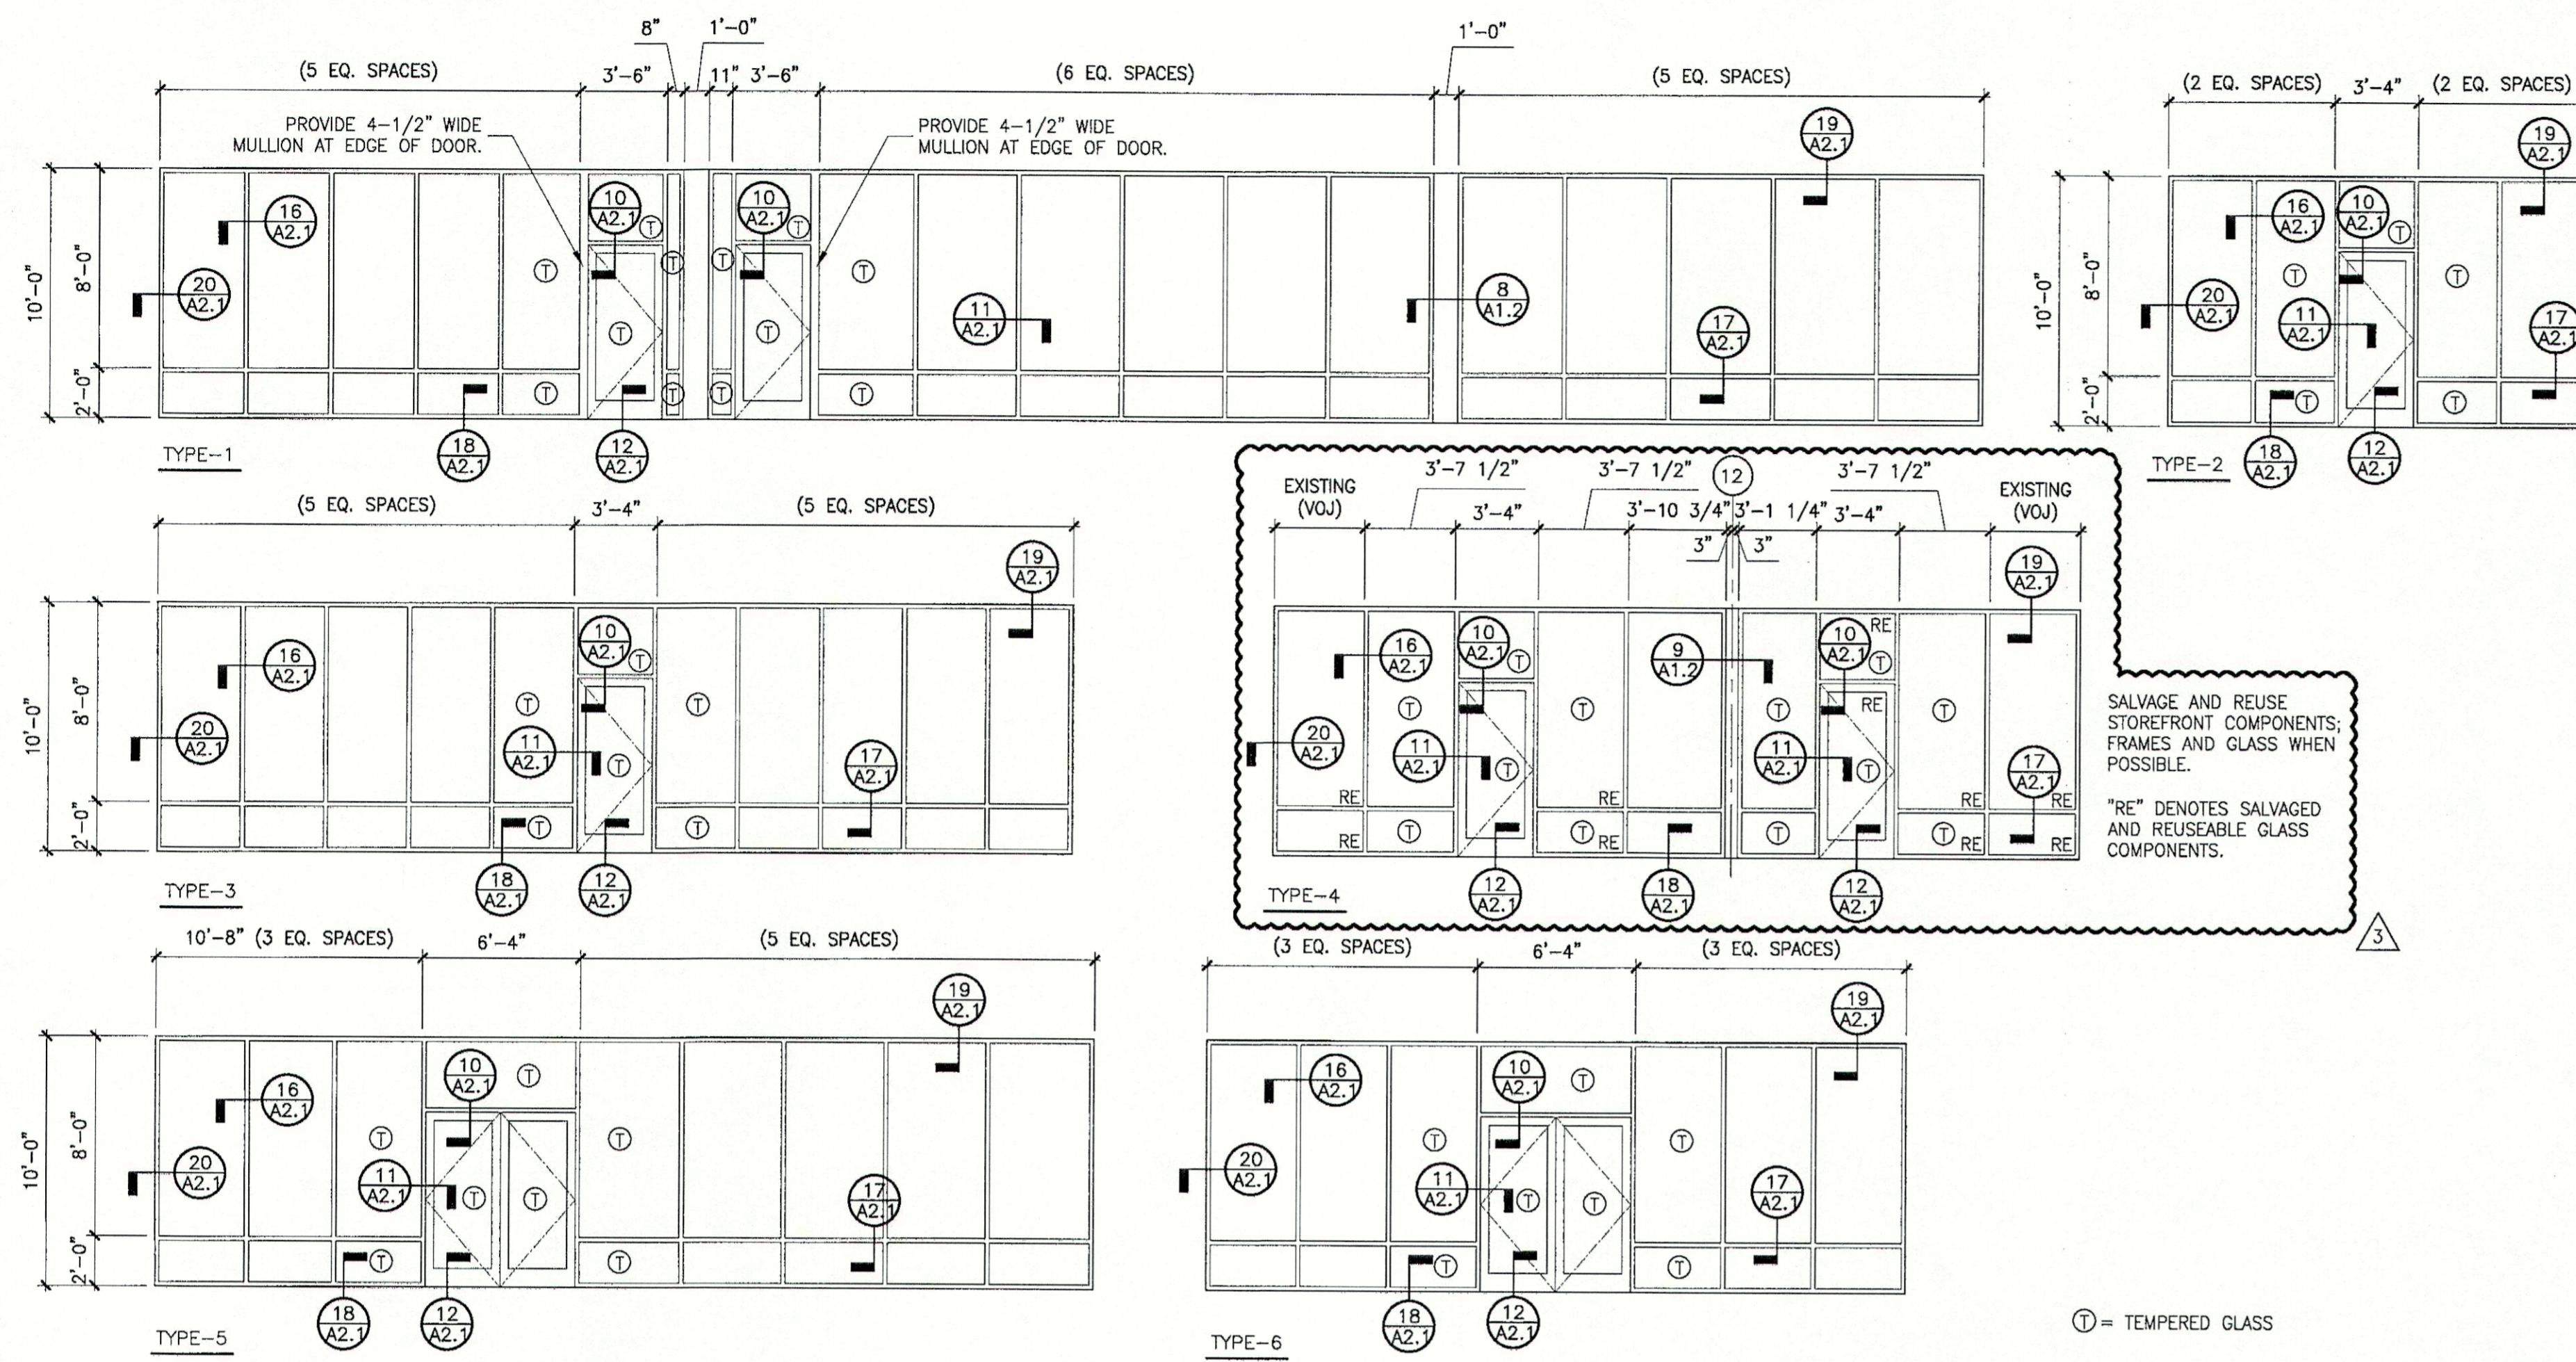

⊕ = TEMPERED GLASS

| REV #   | DATE | DESCRIPTION | BY  |
|---------|------|-------------|-----|
| 12/4/08 |      |             | CJC |
| 3/4/08  |      |             | LWR |
| 9/17/07 |      |             | LWR |

**DDG DUPLANTIS DESIGN GROUP, PC**  
 Respect • Integrity • Client Satisfaction • Excellence  
 THIBODAUX, LOUISIANA  
 Civil Engineering • Site Development • Land Planning • Public Works • Architecture  
 14 East Bayou Road  
 Thibodaux, Louisiana 70301  
 Phone: 985-447-0090  
 Fax: 985-447-0095

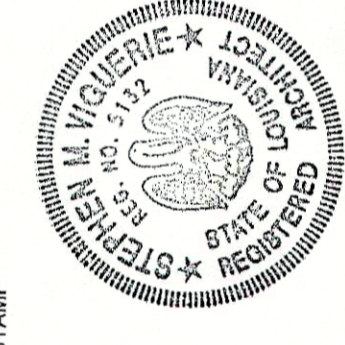Signature: *Steph M. Vergeme*  
 DATE: 12/23/08  


PROPOSED RETAIL DEVELOPMENT  
 CITY OF BOULTE  
 ST. CHARLES PARISH, LOUISIANA  
 FOR THE SPECTRA GROUP, INC.  
 MEMPHIS, TENNESSEE

|             |                     |
|-------------|---------------------|
| DRAWN       | LMR                 |
| CHECKED     | SMV                 |
| DATE        | 8/13/07             |
| SCALE       | AS NOTED ON DWG     |
| PROJECT NO. | 07-205A             |
| FILE:       | REVISION 3/A2.2.DWG |
| SHEET       |                     |

A2.2