


1 SECTION

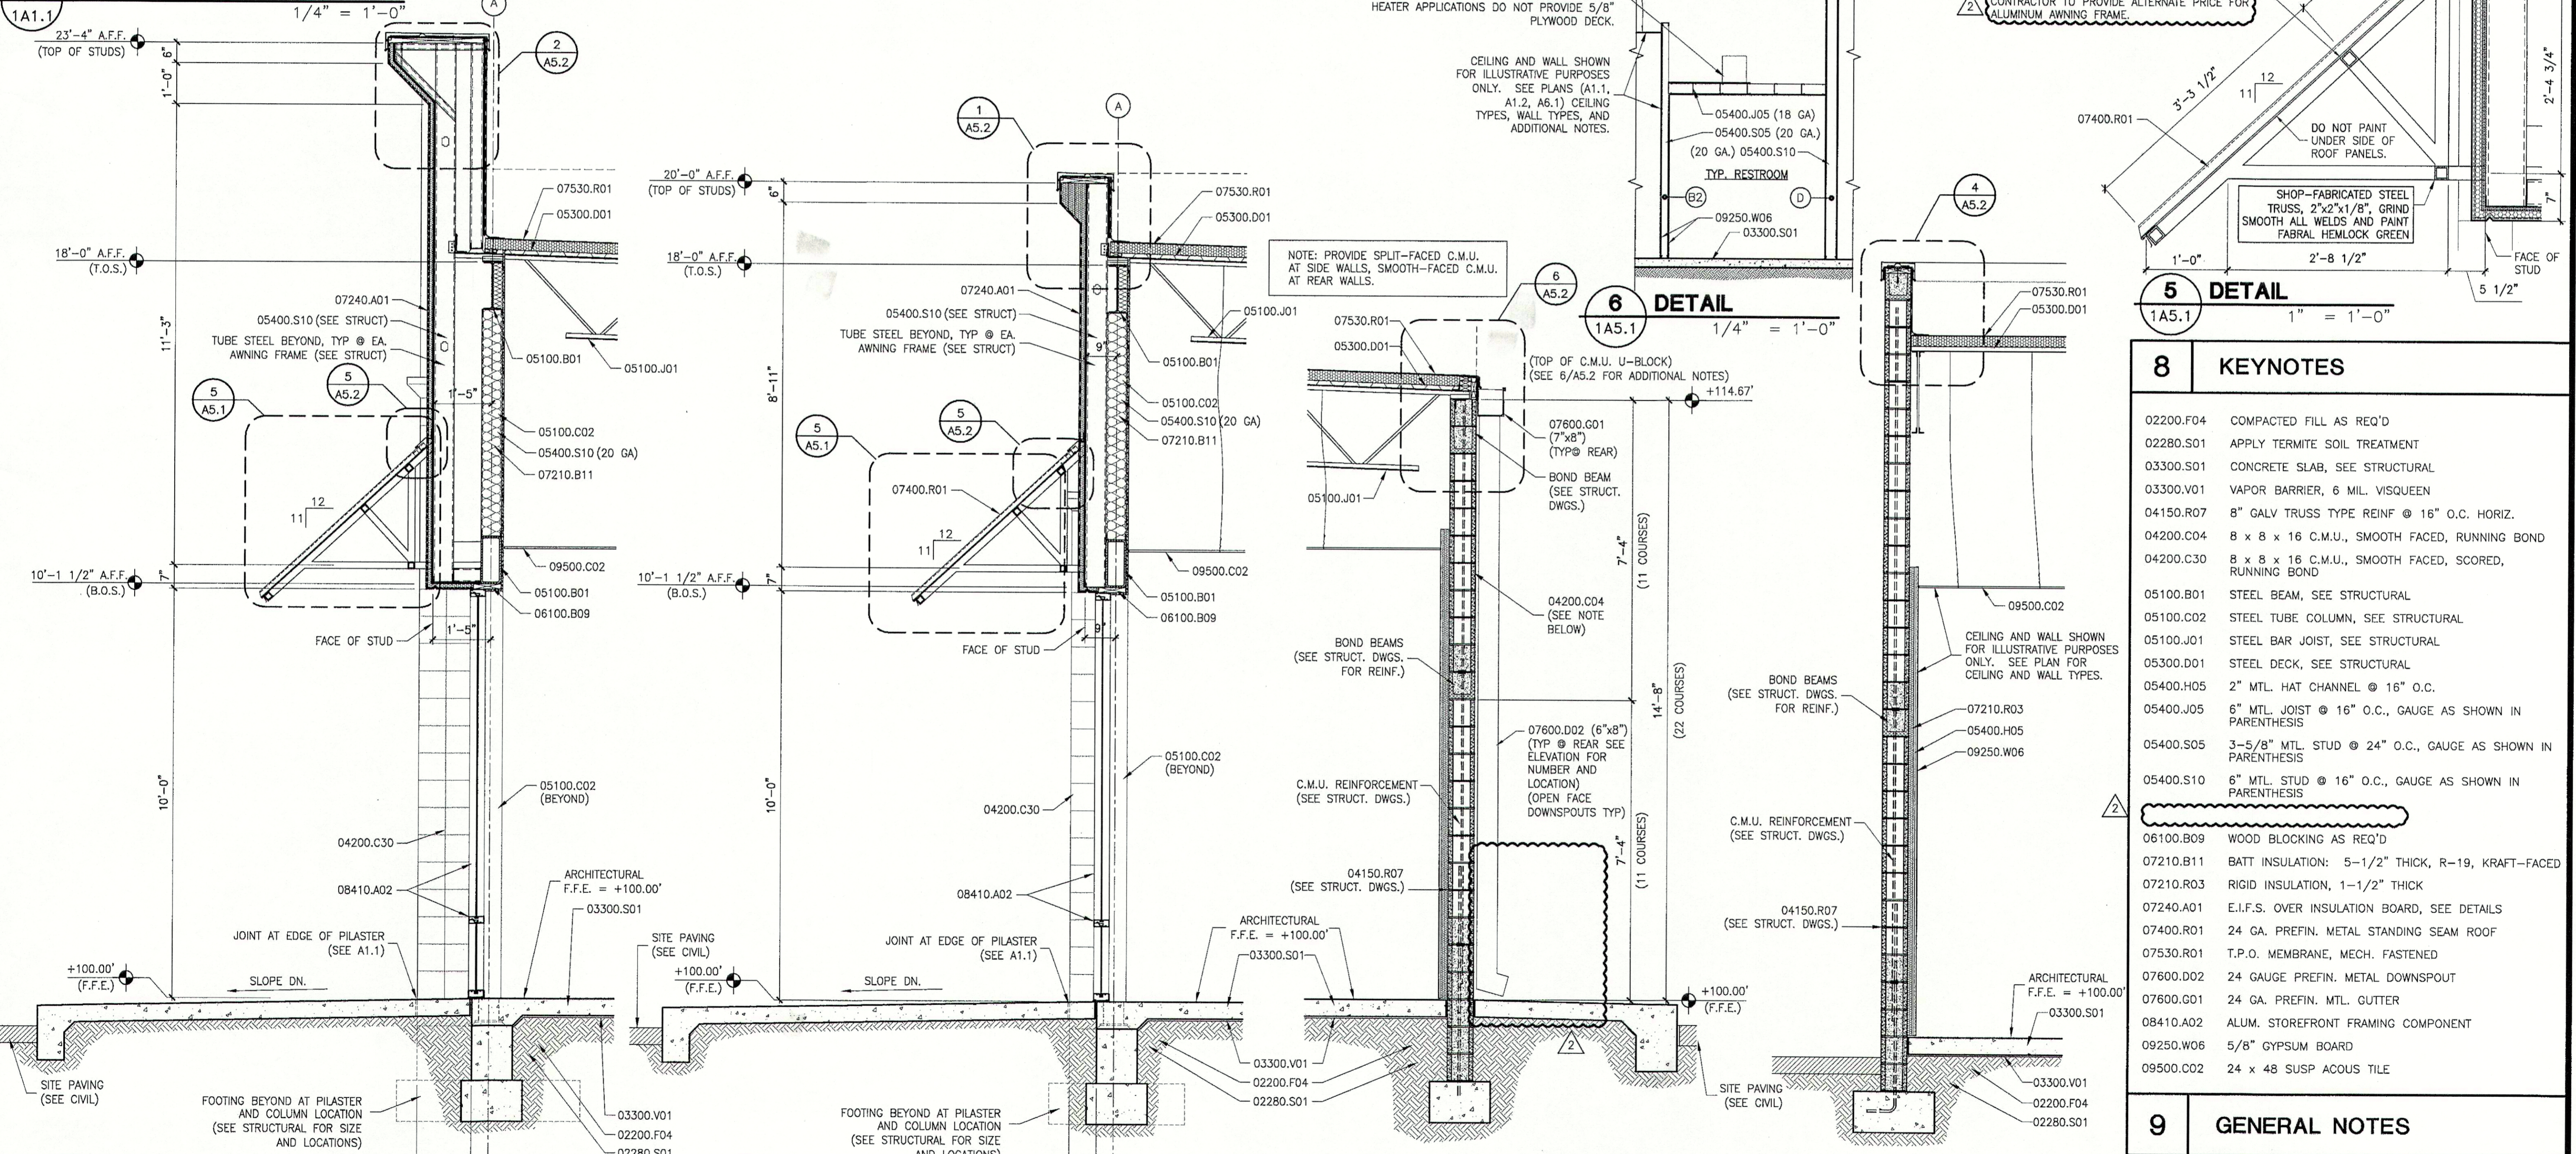

2 DETAIL

3 DETAIL

4 DETAIL

7 DETAIL

6 DETAIL

5 DETAIL

8 KEYNOTES

- 02200.F04 COMPACTED FILL AS REQ'D
- 02280.S01 APPLY TERMITE SOIL TREATMENT
- 03300.S01 CONCRETE SLAB, SEE STRUCTURAL
- 03300.V01 VAPOR BARRIER, 6 MIL. VISQUEEN
- 04150.R07 8" GALV TRUSS TYPE REINF @ 16" O.C. HORIZ.
- 04200.C04 8 x 8 x 16 C.M.U., SMOOTH FACED, RUNNING BOND
- 04200.C30 8 x 8 x 16 C.M.U., SMOOTH FACED, SCORED, RUNNING BOND
- 05100.B01 STEEL BEAM, SEE STRUCTURAL
- 05100.C02 STEEL TUBE COLUMN, SEE STRUCTURAL
- 05100.J01 STEEL BAR JOIST, SEE STRUCTURAL
- 05300.D01 STEEL DECK, SEE STRUCTURAL
- 05400.H05 2" MTL. HAT CHANNEL @ 16" O.C.
- 05400.J05 6" MTL. JOIST @ 16" O.C., GAUGE AS SHOWN IN PARENTHESIS
- 05400.S05 3-5/8" MTL. STUD @ 24" O.C., GAUGE AS SHOWN IN PARENTHESIS
- 05400.S10 6" MTL. STUD @ 16" O.C., GAUGE AS SHOWN IN PARENTHESIS
- 06100.B09 WOOD BLOCKING AS REQ'D
- 07210.B11 BATT INSULATION: 5-1/2" THICK, R-19, KRAFT-FACED
- 07210.R03 RIGID INSULATION, 1-1/2" THICK
- 07240.A01 E.I.F.S. OVER INSULATION BOARD, SEE DETAILS
- 07400.R01 24 GA. PREFIN. METAL STANDING SEAM ROOF
- 07530.R01 T.P.O. MEMBRANE, MECH. FASTENED
- 07600.D02 24 GAUGE PREFIN. METAL DOWNSPOUT
- 07600.J01 24 GA. PREFIN. MTL. GUTTER
- 08410.A02 ALUM. STOREFRONT FRAMING COMPONENT
- 09250.W06 5/8" GYPSUM BOARD
- 09500.C02 24 x 48 SUSP ACOUS TILE

9 GENERAL NOTES

1. EXTEND GYP. BD. TO METAL DECK IN AREAS WITHOUT CEILINGS. IN AREAS WITH CEILINGS INSTALL GYP. BD. 6" ABOVE CEILING HEIGHT.

DATE	DESCRIPTION	BY
3/4/08	REV #3	CJC
9/17/07	REV #1	LMR

DDG DUPLANTIS DESIGN GROUP, PC
 Respect • Integrity • Client Satisfaction • Excellence
 HOUSTON, TEXAS
 THIBODAUX, LOUISIANA
 Civil Engineering • Site Development • Land Planning • Public Works • Architecture
 Phone: 985.447.0099 Fax: 985.447.0099

PROPOSED RETAIL DEVELOPMENT
 CITY OF BOULTE
 ST. CHARLES PARISH, LOUISIANA
 FOR THE SPECTRA GROUP, INC.
 MEMPHIS, TENNESSEE

DATE: 3/5/08
 SIGNATURE: [Signature]

STAMP: PROJECT NO. 07-205A, STATE OF MISSISSIPPI, REGISTERED PROFESSIONAL ENGINEER

PROJECT NO. 07-205A
 FILE: REVISION 3/A5-1DWG
 SHEET

DRAWN: LMR
 CHECKED: SMV
 DATE: 8/13/07
 SCALE: AS NOTED ON DWG
 PROJECT NO. 07-205A
 FILE: REVISION 3/A5-1DWG
 SHEET

A5.1