

DATE	DESCRIPTION	BY
3/13/09	REV #6	CJC
12/14/08	REV #5	CJC
6/15/08	REV #4	CJC
2/26/08	REV #3	LMR
9/17/07	REV #1	LMR


DDG DUPLANTIS DESIGN GROUP, PC
 Respect • Integrity • Client Satisfaction • Excellence
 THIBODAUX MANDEVILLE HOUSTON
 Civil Engineering • Site Development • Land Planning • Architecture
 141 East Bopar Road
 314 Highway, Suite 200
 Houston, Louisiana 77060
 Phone: 281.447.7000

STAMP
 SIGNATURE: *Stu M. Mc*
 DATE: 3/17/09




PROPOSED RETAIL DEVELOPMENT
CITY OF BOUETTE
ST. CHARLES PARISH, LOUISIANA
FOR THE SPECTRA GROUP, INC.
MEMPHIS, TENNESSEE

DRAWN	LMR
CHECKED	SMV
DATE	8/13/07
SCALE	AS NOTED ON DWG
PROJECT NO.	07-205A
FILE	REVISION 6\A6-1DWG
SHEET	A6.1

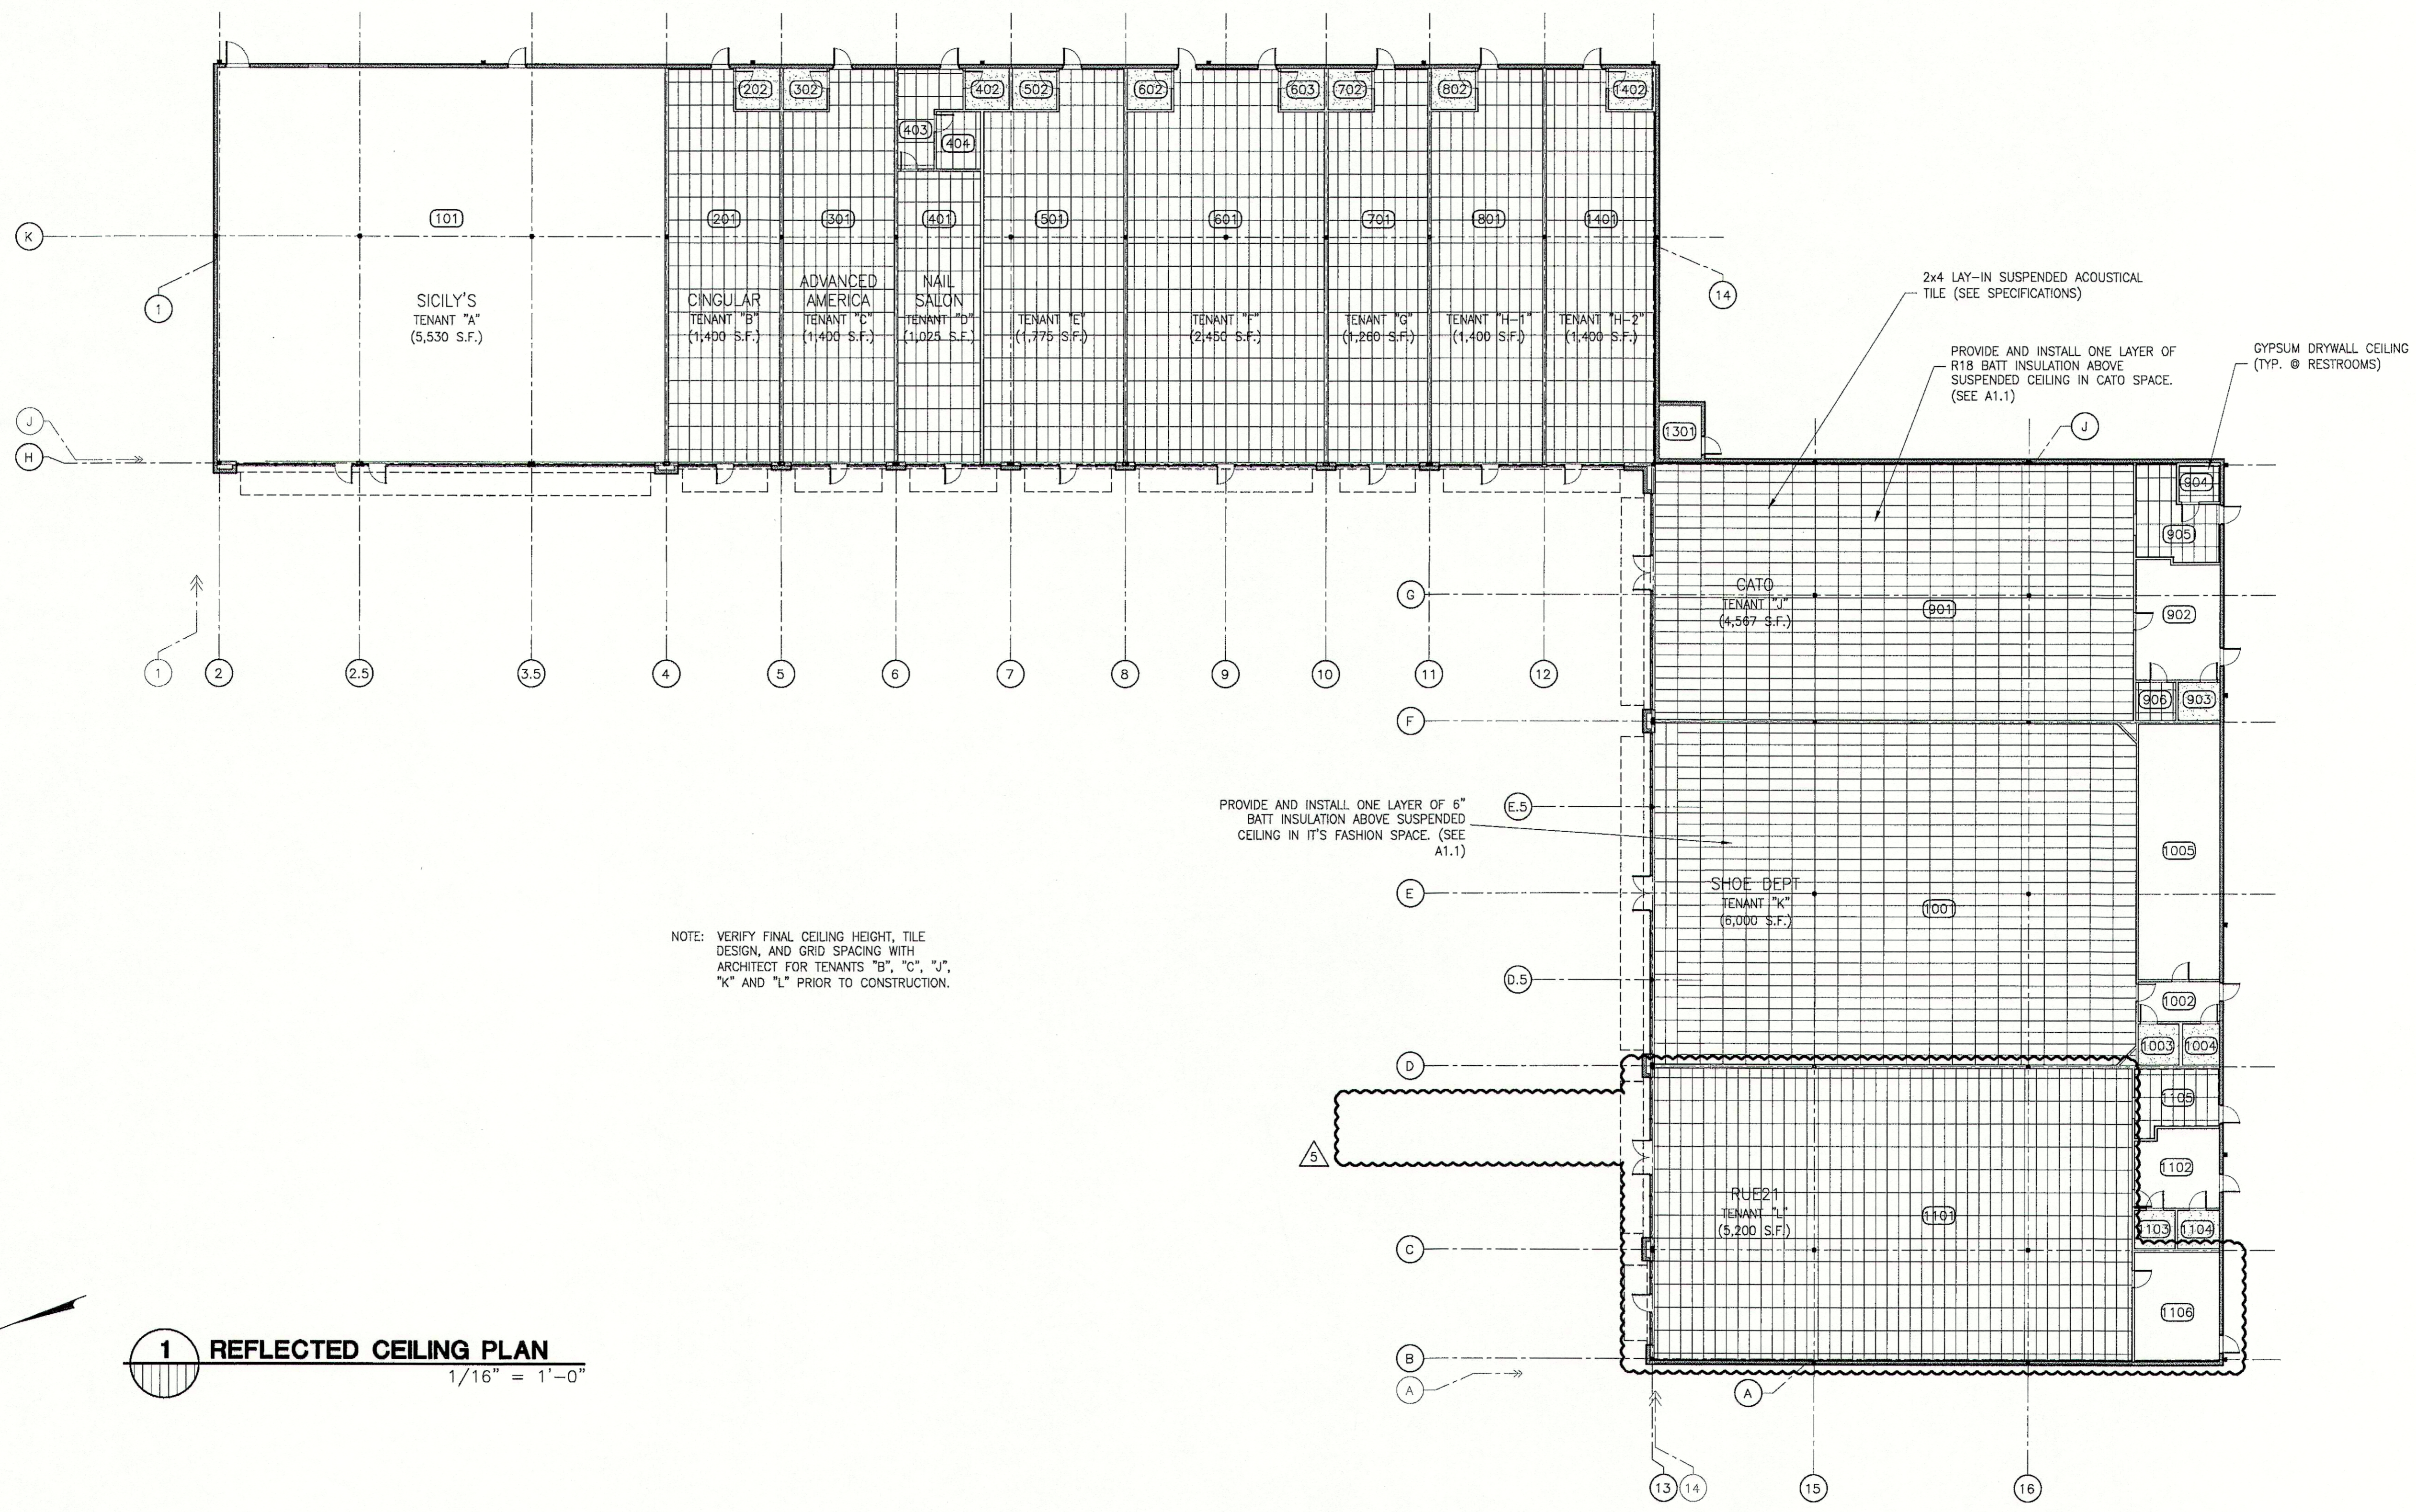

1 REFLECTED CEILING PLAN
 1/16" = 1'-0"

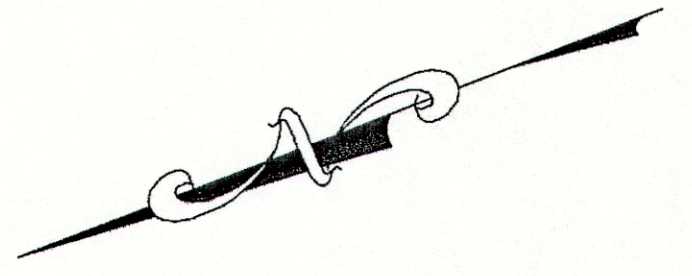

I:\07-000\07-205A\Rev #6 (3-5-09)\A6-1.dwg, 3/17/2009 8:14:43 AM, lreirce