GENERAL ELECTRICAL NOTES:

1. COORDINATE WITH OWNER, LOCATIONS OF ALL TELEPHONE AND ELECTRICAL SERVICE STUB-UPS INSIDE OF BUILDING.
2. ALL CONDUIT SHALL BE MIN 1/2" DIAMETER UNLESS OTHERWISE NOTED.
3. VERIFY EXACT LOCATION OF ALL OUTLETS AND FIELD COORDINATE PRIOR TO ANY WORK.
4. PROVIDE JUNCTION BOX AND 3/4" CONDUIT WITH PULLWIRE STUBBED ABOVE ACCESSIBLE CEILING FOR ALL DATA AND COMMUNICATION DEVICE LOCATIONS. VERIFY EXACT LOCATIONS WITH SPECIFIC TENANTS PRIOR TO ROUGH-IN.
5. LOW VOLTAGE WIRING FOR THERMOSTAT CONTROLS IS BY THE MECHANICAL CONTRACTOR. ELECTRICAL CONTRACTOR SHALL PROVIDE CONDUIT WITH PULL WIRES AND BACK BOXES AS NECESSARY FOR ROUGH-IN OF THERMOSTATS. COORDINATE LOCATIONS WITH MECHANICAL CONTRACTOR PRIOR TO ROUGH-IN.
6. ADDITIONAL FIRE ALARM NOTIFICATION APPLIANCES WILL BE PROVIDED UNDER INDIVIDUAL TENANT FINISH CONTRACTS AS NECESSARY.
7. DUCT SMOKE DETECTORS SHALL TRANSMIT A SUPERVISORY SIGNAL TO THE FIRE ALARM CONTROL PANEL AS REQUIRED BY LOCAL AHJ.

ELECTRICAL PLAN NOTES:

[1] LOW VOLTAGE DUCT SMOKE DETECTOR FURNISHED BY MECHANICAL CONTRACTOR. WIRE DUCT SMOKE DETECTOR FOR SHUT-DOWN OF RTU. PROVIDE SHUT-DOWN PER INDIVIDUAL TENANT CRITERIA. PROVIDE LOW VOLTAGE WIRING TO REMOTE INDICATOR LIGHTS, REMOTE TROUBLE LIGHTS, AND TEST/RE-SET STATIONS MOUNTED IN CEILING. IN UNFINISHED SPACES, TEMPORARILY MOUNT DEVICES AT ROOF JOISTS. LEAVE ENOUGH WIRE TO ALLOW PERMANENT MOUNTING IN CEILING BY TENANT.

[2] CEILING MOUNT RECEPTACLE NEAR WINDOWS FOR SHOW WINDOW LIGHTING/DISPLAY. (1)

[3] PROVIDE FUSED DISCONNECT SWITCH, SIZE INDICATED ON PLANS.

[4] WIRE RECEPTACLE FURNISHED WITH UNIT.

[5] ELECTRIC WATER HEATER MOUNTED ABOVE CEILING. PROVIDE 30 AMP, TOGGLE SWITCH. REFER TO PLUMBING SHEETS.

[6] PROVIDE 1-1/4" CONDUIT WITH PULL STRING FROM PHONE BOARD LOCATION IN TENANT SPACE, ABOVE CEILING AND TERMINATED AT THE MAIN DEMARK BOARD IN SPRINKLER ROOM.

[7] JUNCTION BOX FOR STORE FRONT SIGNAGE. VERIFY LOCATION. PROVIDE 3/4" CONDUIT STUBBED THRU WALL AS REQUIRED. PROVIDE LOCAL DISCONNECT SWITCH AS REQUIRED BY NEC IF NOT FURNISHED WITH SIGN.

[8] HOMERUN CIRCUIT(S) THROUGH CONTACTOR CONTROLLED BY PHOTOCELL AND/OR TIME SWITCH. REFER TO CONTACTOR SCHEDULE FOR CONTROL SEQUENCE.

[9] FUTURE JUNCTION BOX FOR STORE SIGNAGE.

[10] PROVIDE 2 POLE 20 AMP, TOGGLE SWITCH AND POWER CONNECTION FOR INSTANTANEOUS WATER HEATER. REFER TO PLUMBING SHEETS. (2)

[11] NOT USED

[12] NOT USED (3)

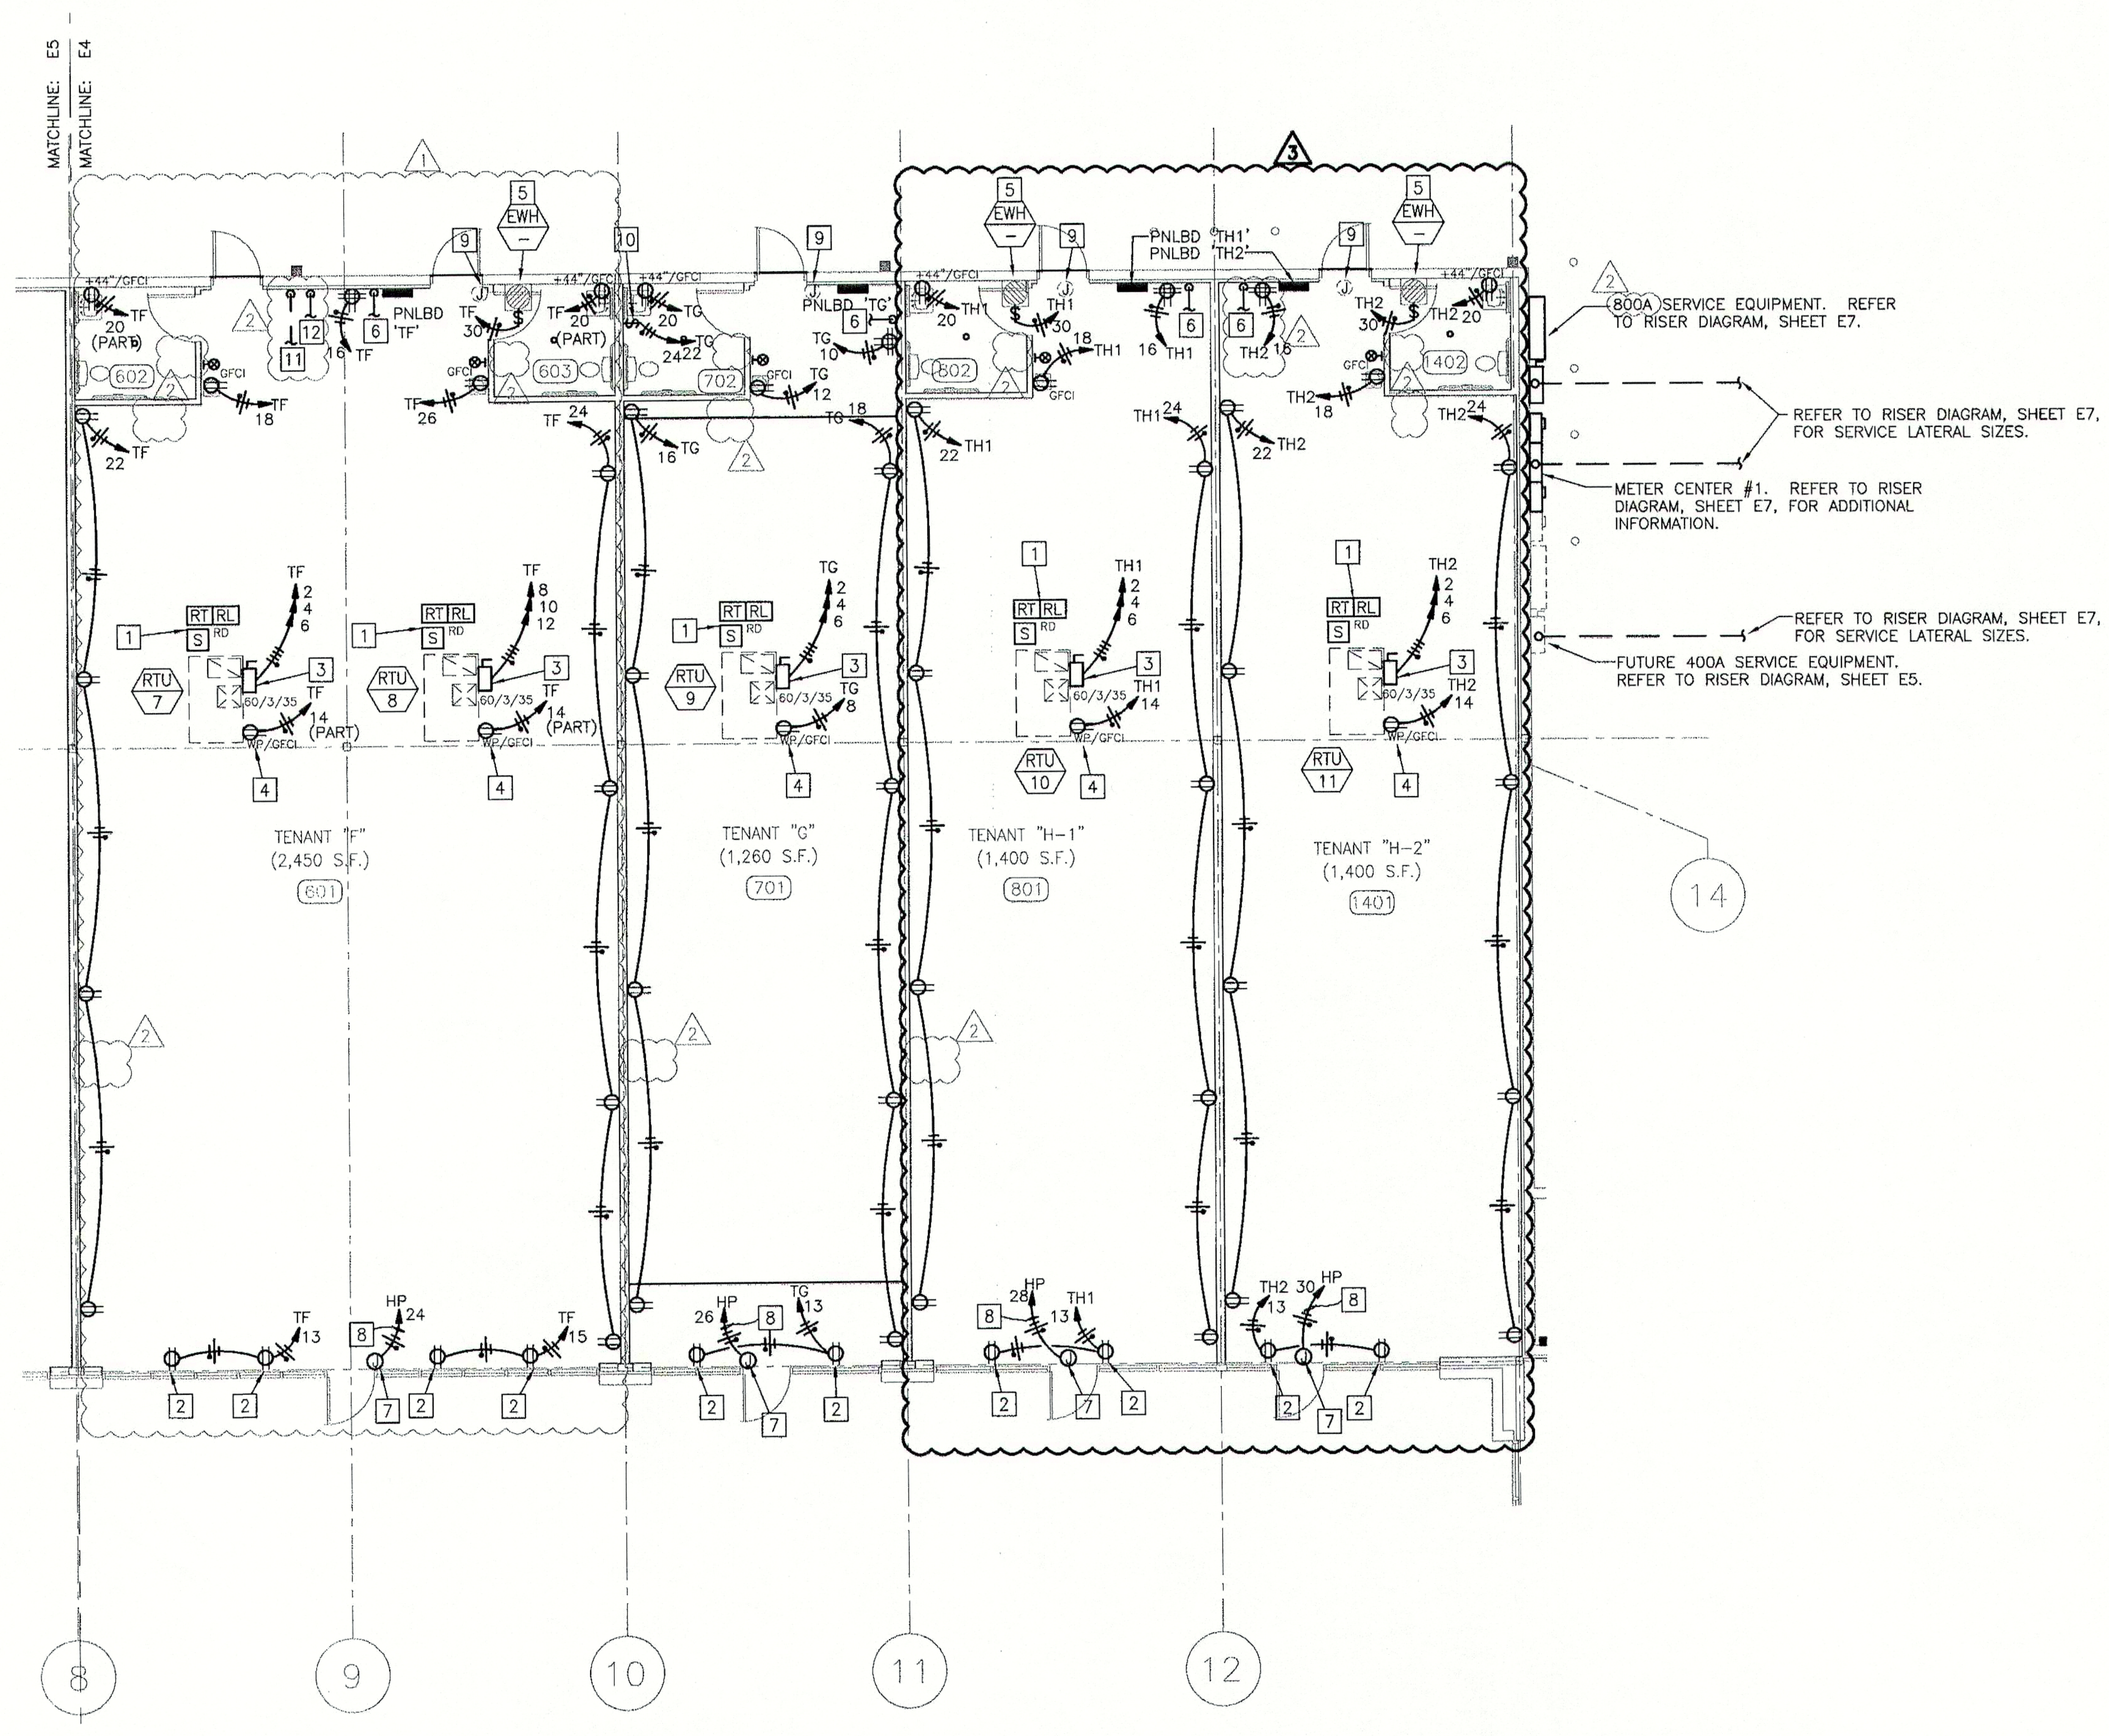

1 POWER FLOOR PLAN
SCALE: 1/8"=1'-0"

1	3/04/08	REVISION #3	FLS
2	6/05/08	REVISION #4	FLS
3	12/04/08	REVISION #5	DWL
	DATE	DESCRIPTION	BY

REVISION

DDG DUPLANTIS DESIGN GROUP, PC
Respect ▪ Integrity ▪ Client Satisfaction ▪ Excellence
THIBODAUX MANDEVILLE HOUSTON
Civil Engineering ▪ Site Development ▪ Land Planning ▪ Public Works ▪ Architecture
314 East Bayou Road
Thibodaux, Louisiana 70301
Phone: 985.447.0090
Fax: 985.447.7009

SIGNATURE:
DATE:

STAMP
STATE OF LOUISIANA
CRAIG R. LANHAM
REG. No. 25559
REGISTERED PROFESSIONAL ENGINEER
IN ELECTRICAL ENGINEERING
12-3-08

PROPOSED RETAIL DEVELOPMENT
CITY OF BOUTTE
ST. CHARLES PARISH, LOUISIANA

FOR THE SPECTRA GROUP, INC.
MEMPHIS, TENNESSEE

DRAWN	FLS
CHECKED	DWL
DATE	8/13/07
SCALE	AS NOTED ON DWG
PROJECT NO.	0750001106
FILE:	0650001106E5.DWG
SHEET	E5

HENDERSON ENGINEERS INC
8325 LENEXA DRIVE
LENEXA, KS 66214
TEL 913 742 5000 FAX 913 742 5001
www.hei-eng.com
0750001106