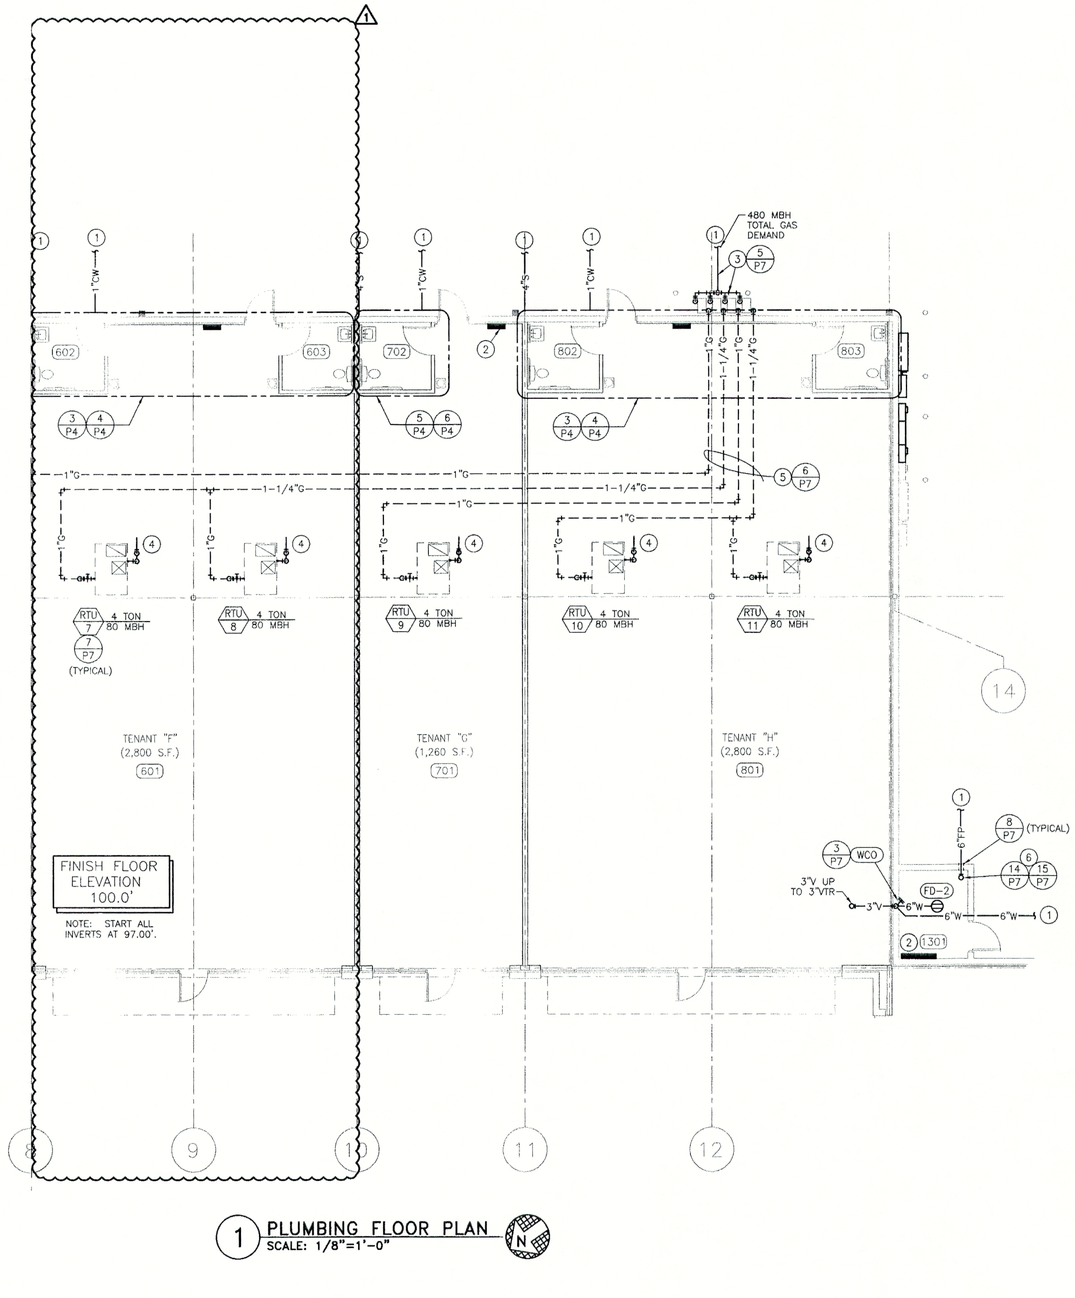

1 PLUMBING FLOOR PLAN
SCALE: 1/8"=1'-0"

PLUMBING PLAN NOTES:

1. REFERENCE CIVIL DRAWINGS FOR CONTINUATION
2. NO PLUMBING RELATED PIPING SHALL BE ROUTED OVER ELECTRICAL PANELS.
3. GAS SERVICE LINE AND METER BANK PROVIDED BY LOCAL GAS UTILITY COMPANY. COORDINATE GAS SERVICE LINE INSTALLATION TO BUILDING WITH LOCAL GAS UTILITY COMPANY BEFORE WORK BEGINS. ON HOUSE SIDE OF GAS METER, COORDINATE TENANT GAS PRESSURE TO BE 7"–10" WATER COLUMN FOR EACH METER.
4. PROVIDE ROOFTOP UNIT CONDENSATE DRAIN WITH P–TRAP. EXTEND DRAIN LINE AWAY FROM UNIT WHERE CONDENSATE DRAINAGE FLOWS TO NEAREST ROOF DRAINAGE SYSTEM AND DOES NOT COLLECT IN WORKING AREA AROUND UNIT. CONDENSATE SHALL BE INSTALLED PER AUTHORITY HAVING JURISDICTIONS.
5. GAS PIPING ON ROOF.
6. PROVIDE 6" FIRE PROTECTION WATER ENTRY IN MECHANICAL ROOM. REFERENCE CIVIL DRAWINGS FOR FIRE LINE INSTALLATION, EXTERIOR BACKFLOW PREVENTER AND WATER METER IF REQUIRED.

8/29/07	REVISION #1	CRM

DUPLANTIS DESIGN GROUP PC

SIGNATURE:

STAMP

PROPOSED RETAIL DEVELOPMENT
CITY OF BOUTTE
ST. CHARLES PARISH, LOUISIANA

DR
CHE
D
8/
SC
AS NOTE
PROJ
0750
F
0750001
SH

HENDERSON ENGINEERS INC
8325 LENEXA DRIVE
LENEXA, KS 66214
TEL 913.742.5000 FAX 913.742.5001
www.hei-eng.com
0750001106