



twenty-two
~~22~~ Shopping Center

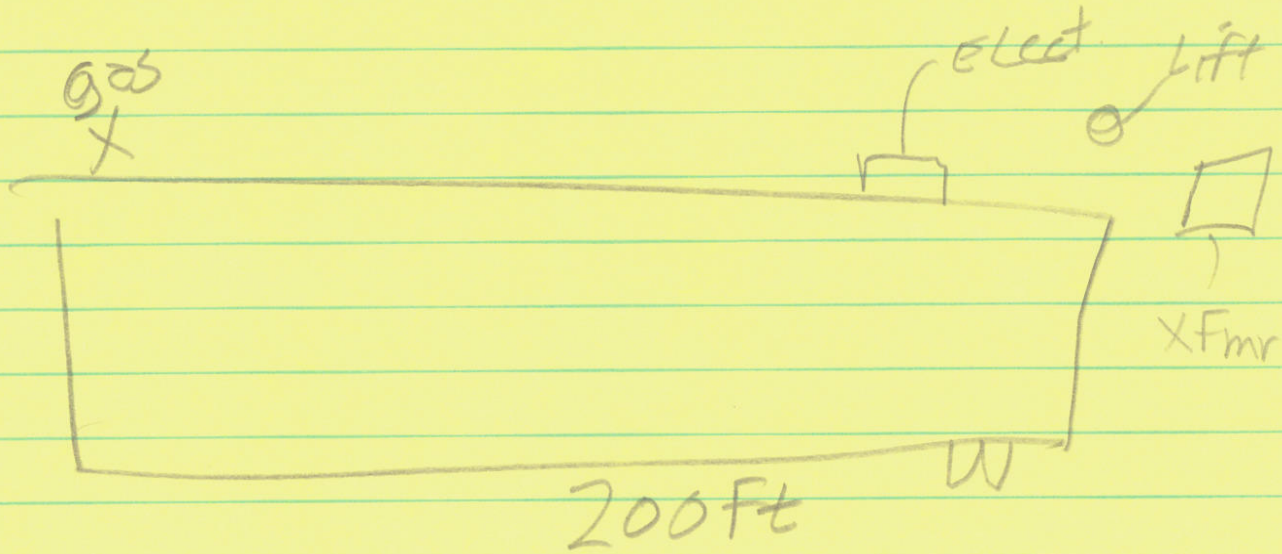

HVAC 38 ARZ007---501---
Min Cir. Amps 25.8

12,000 Btu 6 ton

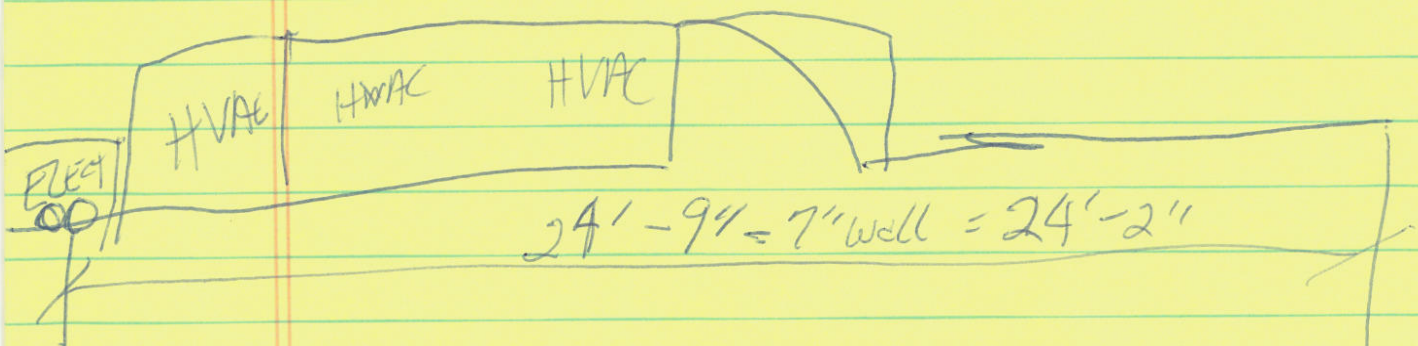


14'-1" Roof Ceiling height

Panel Power

1'-8 1/2"

200A Service

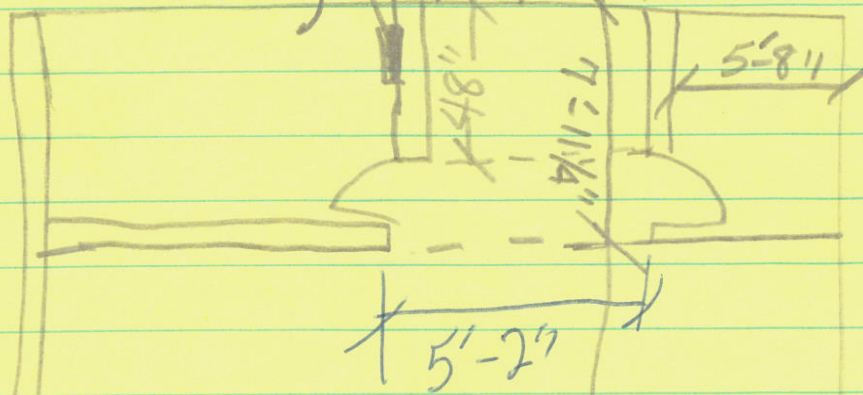

- 3φ 1-30
- 1-40
- 1-60
- 1-80

1φ 26-20

CLAMP ON



26 3/4"


8" to center leave room for demising wall

22'-4"

18"

13 1/2"

66-2
 98
 74-2

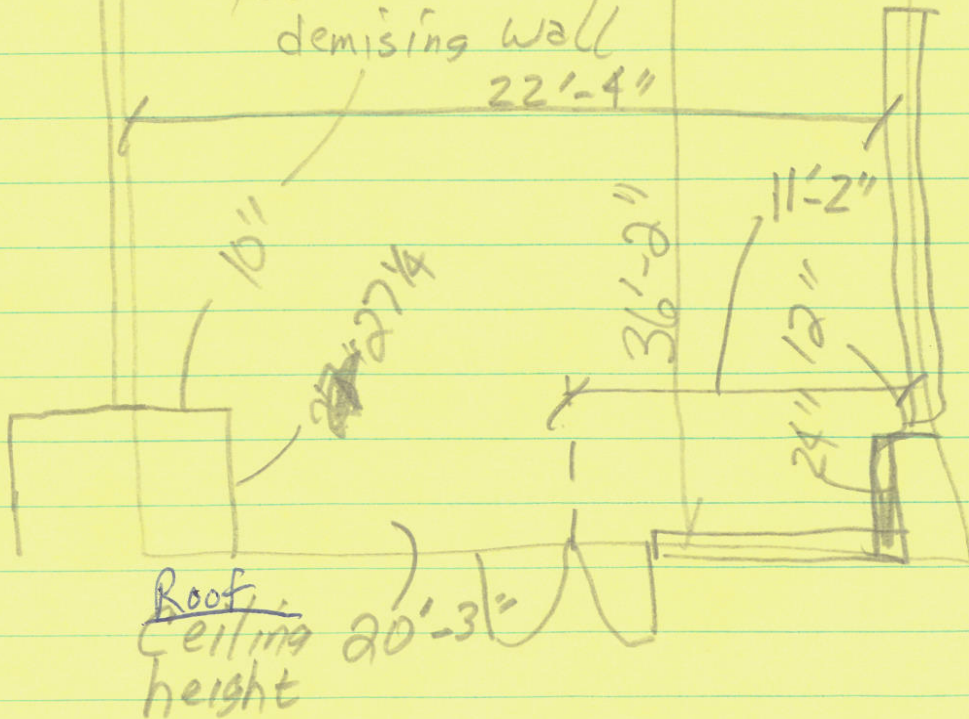

Roof Ceiling height 20'-3"

