

Earl
Bail Out?

(#1) 155 DL


Silica is removed
by a demineralizer
2) Chemical treatment
3) Sulfite treatment

SWE Ben Guies
recommends


Earl

Conductivity Meter (Hand Held)

- ① Continuous Bleeddown
- ② Sample Point



4080D-150S

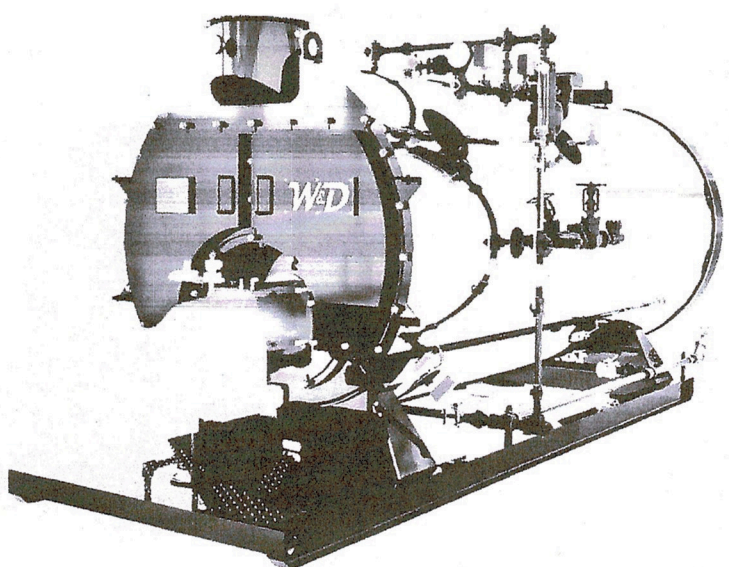

DOCUMENT RELEASE
RECIPIENT SOLELY RESPONSIBLE FOR DOCUMENT CONTROL - DISTRIBUTION AND/OR DUPLICATION PROHIBITED
NOTIFY WILLIAMS & DAVIS BOILERS IMMEDIATELY IF RECEIVED BY UNLISTED RECIPIENT(S)

PREPARED BY: HC DATE: 03/01/2021 RELEASE DURATION: _____

RECIPIENT: CONTROL & INSTRUMENT SERVICES, INC., SLIDELL, LA AUTHORIZATION: REVIEW - NON-DISTRIBUTED

TRACKING NUMBER: 2459247.45236.12

DOCUMENT APPROVAL
PRODUCTION IS UNABLE TO BEGIN UNTIL THIS PAGE IS SIGNED AND RETURNED. RECIPIENT SIGNATURE REPRESENTS ACCEPTANCE OF LISTED SPECIFICATIONS. IF CHANGES ARE REQUESTED BY RECIPIENT, THIS DOCUMENT WILL REQUIRE REVIEW AND REQUIRING PRIOR TO APPROVAL AND START OF PRODUCTION PERIOD. IF DIMENSIONS, RATINGS, OR SPECIFICATIONS REQUIRE ADJUSTMENT TO ACCOMMODATE PRODUCTION, PERFORMANCE OR DELIVERY, W&D RESERVES THE RIGHT TO PERFORM ADJUSTMENTS WITH OR WITHOUT NOTICE.

NAME/TITLE: _____ SIGNATURE: _____ DATE: _____

DESIGN INFORMATION

CERTIFIED BY W&D TYPE: FIRE TUBE MAX TEMP: 400°F
YEAR BUILT: 2021 SIZE: 60 HP HS: 400 84 FT
MAWP: 150 PSI # OF PASSES: _____
MDSC: 2,760 LB/MH CORROSION ALLOWANCE: _____

US CUSTOMARY UNITS
UNLESS OTHERWISE NOTED

TOLERANCE: ± 0.005

FRACTION: 1/16
DEC: 0.12
DEC: 0.125
ANGLE: 81.00°

Williams & Davis Boilers
TEL: 972.275.2500 FAX: 972.255.9789
WWW.WD&D.COM

APPROVAL (SIGN & DATE): _____ MFG APPROVED BY: _____ PROJECT NO: 81778

DATE APPROVED: _____ SCALE: _____ PART DESCRIPTION: _____


DWG. NO.: 4080D-150S-81770-SUB REVISION: A DWG DATE: 2/1/2021 CHECKED BY: HC

TIME DESCRIPTION: 4-PASS 60 HP DRY BACK, 150 PSI STEAM, SN 81770, TN: 2459247.45236.12

PART NO.: _____ REVISION: _____ DESIGN BY: _____ DESIGN DATE: _____ CHECKED BY: _____ DATE: _____

Cy M 2/9/21

DESIGN SPECIFICATIONS

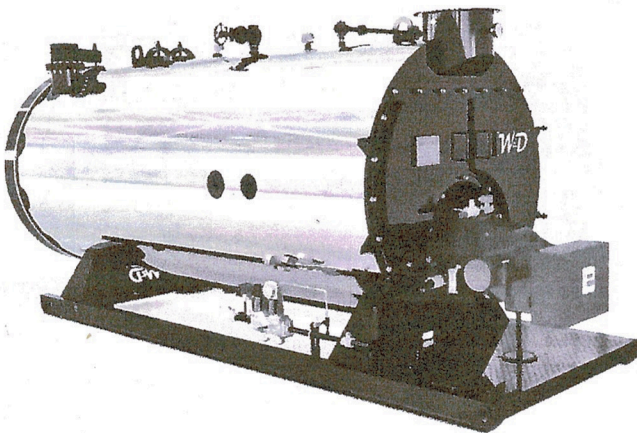


MODEL NUMBER	4080D-150S
DESCRIPTION	4 PASS 80 HP DRY BACK, 150 PSI STEAM
JOB NUMBER(S)	81770
ASME BPVC SECTION	I
ASME BPVC EDITION	2019
SITE ALTITUDE	10 FT. ASL
MAXIMUM VESSEL PRESSURE	150 PSI
MAXIMUM RECOMMENDED OPERATING PRESSURE	143 PSI
MAXIMUM DESIGNED STEAM CAPACITY	2,760 LBS/HR FROM AND AT 212°F
SAFETY RELIEF VALVE CAPACITY, TYP.	3,200 LB/HR
SAFETY RELIEF VALVE SET PRESSURE	150 PSI
BLOWDOWN VALVE	250 PSI SS BALL VALVE, 160 PSI Y BLOW-OFF VALVE
PRESSURE GAUGE MODEL	4-1/2, 0-300 PSI PRESSURE GAUGE
OUTPUT, BOILER HORSEPOWER	80 HP
OUTPUT, BOILER, BTU	2,678,000 BTU/HR
WATER CONSUMPTION, TYP.	5.5 GPM
HEATING SURFACE	400 SQ. FT.
EXHAUST TEMPERATURE	450°F, TYP. HIGH FIRE
EXHAUST FLOW, TYP.	485.8 ACFM
BURNER MODEL	VG-34/F
BURNER EMISSION STANDARD RATING	STANDARD
ENVIRONMENT RATING	NEMA 4
FLAME SAFEGUARD MODEL	SIEMENS LMV 52
FIRING RATE CONTROL	SIEMENS LMV 52
OPERATING RANGE CONTROL	INTERNAL ADJ., E/M, L404F

SHEET 2 OF 9 PROJECT NO.: _____ PART NO.: _____		4-PASS 80 HP DRY BACK, 150 PSI STEAM, SN 81770, TN: 2459247.45236.12 REVISION: _____ DESIGN BY: _____ DESIGN DATE: _____ CHECKED BY: _____ DATE: _____	
APPROVAL (SIGN & DATE): _____ INFO APPROVED DATE: _____	PER VIEW: _____ SCALE: _____	PART DESCRIPTION: _____	

Coy Mc 2/9/21


DESIGN SPECIFICATIONS

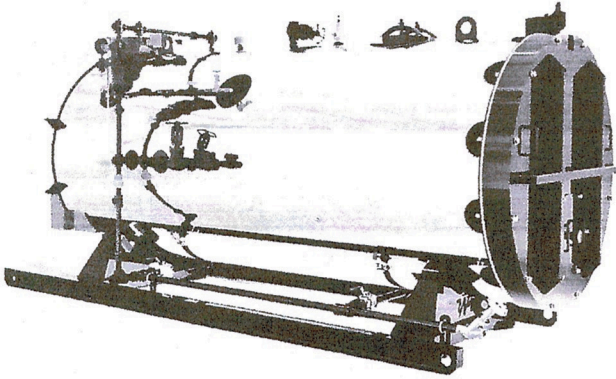

HIGH STEAM PRESSURE LIMIT CONTROL	INTERNAL ADJ., E/M, L4079
PRIMARY LOW WATER CUT OFF	FLOAT TYPE, E/M, 157S
SECONDARY LOW WATER CUT OFF	PROBE TYPE, MANUAL RESET, 26M
PUMP CONTROL	FLOAT TYPE, E/M, 1 EXTERNAL SYS CONTACT, 157S
SUPPLY VOLTAGE	480VAC / 3PH / 60HZ
MAX CONTINUOUS AMPERAGE	4.5 FLA
LOCKED ROTOR AMPERAGE	10 AMPS
PRIMARY FUEL TYPE	LP GAS
SECONDARY FUEL TYPE	-
IGNITION FUEL TYPE	LP GAS
PRIMARY FUEL MAXIMUM DESIGN PRESSURE	5 PSI
PRIMARY FUEL MINIMUM SUPPLY PRESSURE	1 PSI
PRIMARY FUEL MAXIMUM SUPPLY RATE	1,291 SCFH
SECONDARY FUEL SYSTEM OPERATING PRESSURE, TYP.	-
SECONDARY FUEL SYSTEM MAXIMUM INLET PRESSURE	-
SECONDARY FUEL FLOW MAXIMUM RATE	-
SECONDARY FUEL SYSTEM BYPASS RETURN PRESSURE	-
JACKET MATERIAL	STAINLESS STEEL, 304L
JACKET FINISH	2B
NOMINAL WATER CAPACITY	4,027 GAL
FLOODED WATER CAPACITY	4,806 GAL
SHIPPING WEIGHT	14,639 LBS
NOMINAL OPERATING WEIGHT	48,278 LBS
FLOODED WEIGHT	54,724 LBS
CERTIFICATIONS, BOILER AND/OR BURNER	ASME, NATIONAL BOARD, UL

APPROVAL: (SIGN & DATE) INFO APPROVED BY: [blank] INFO APPROVED DATE: [blank]	SHEET 3 OF 9 PROJECT NO.: [blank] SIZE: [blank] SCALE: [blank] PER VIEW: [blank]	PART NO.: [blank] PART DESCRIPTION: [blank]	REVIEWED BY: [blank] DESIGN BY: [blank] CHECKED BY: [blank] DATE: [blank]

Coy Pru 2/9/21

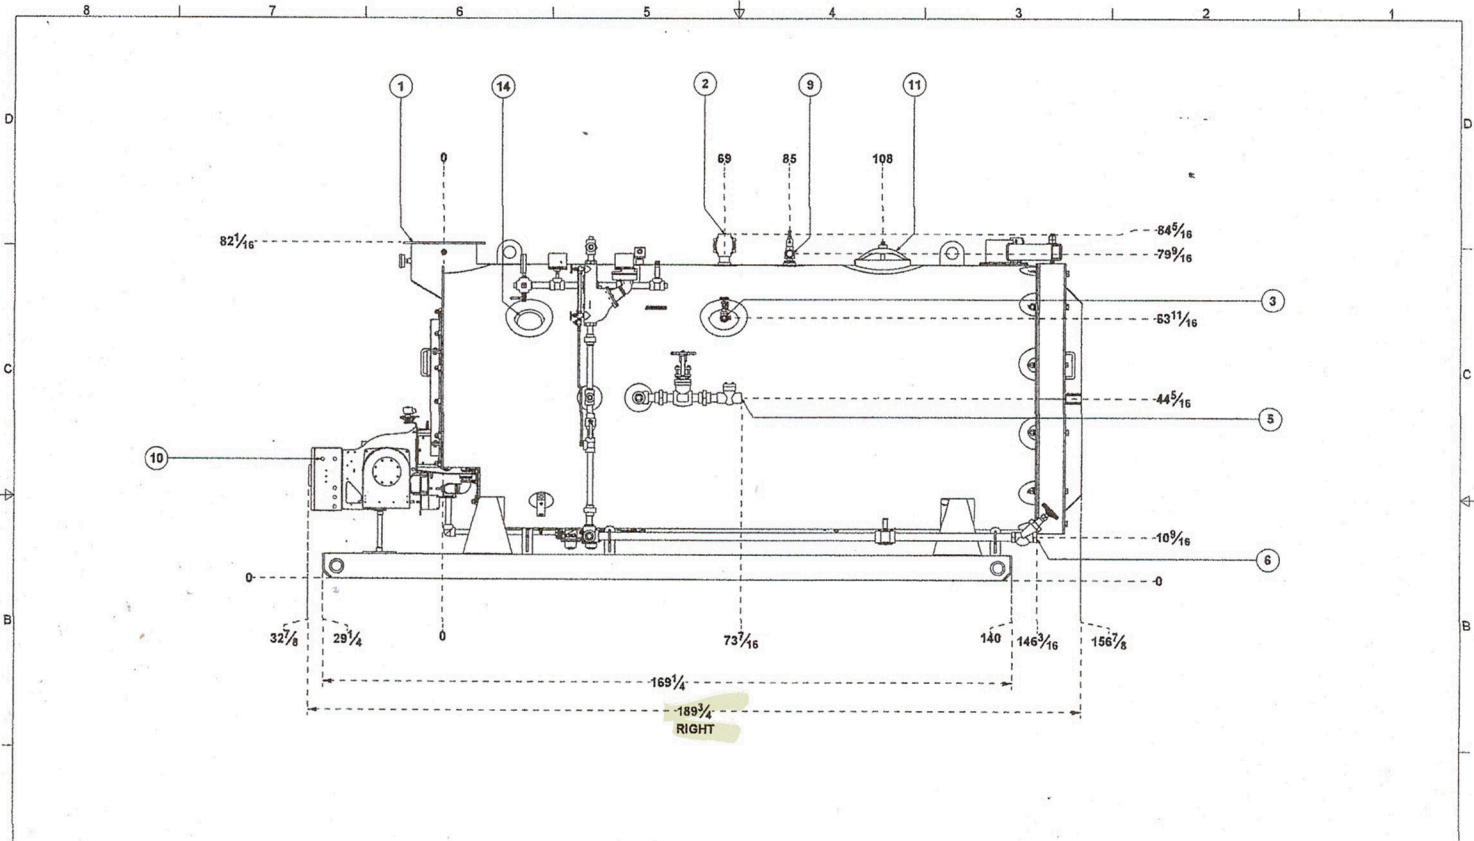


ITEM	DESCRIPTION	CONNECTION LIST	SIZE	TYPE	QTY
Williams & Davis Boilers
 www.wdboiler.com

DRWG NO:	4080D-150S-81770-SUB	REVISED:	A	DRWG BY:	PHC	DRWG DATE:	2/1/2021	CHECKED BY:		DATE:
DRWG DESCRIPTION:	4-PASS 80 HP DRY BACK, 150 PSI STEAM, SN 81770, TN: 2459247.45236.12				PART NO:		REVISED:		DESIGN BY:	
APPROVED:	(SIGN & DATE)	MFG APPROVED BY:		SHEET 5 OF 9	PROJECT NO:	8179	PART DESCRIPTION:		CHECKED BY:	
MFG APPROVED DATE:		SCALE:	PER VIEW							

Coy Bran 2/9/21

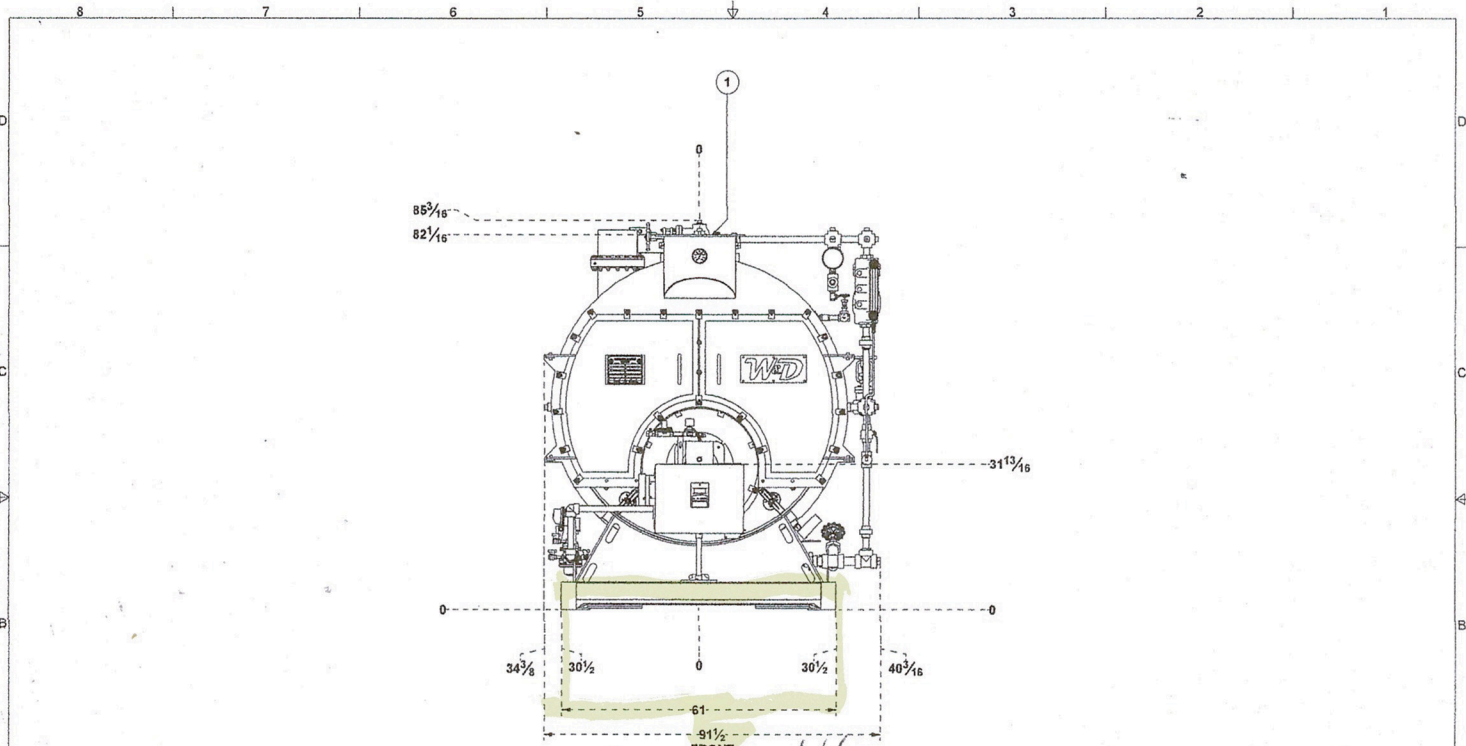


91" Not Acceptable
 Confirm 74" — Pump electrical enclosure has been approved
 GB

ITEM	DESCRIPTION	CONNECTION LIST	SIZE	TYPE	QTY
Williams & Davis Boilers
 4080D-150S-81770-SUB
 4-PASS 80 HP DRY BACK, 150 PSI STEAM, SN 81770, TN: 2459247.45236.12

APPROVAL (SIGN & DATE): _____ MFG APPROVED BY: _____ PROJECT NO.: _____
 INFO APPROVED DATE: _____ SCALE: _____ PART DESCRIPTION: _____
 PER VIEW: _____

Cy R 2/9/21

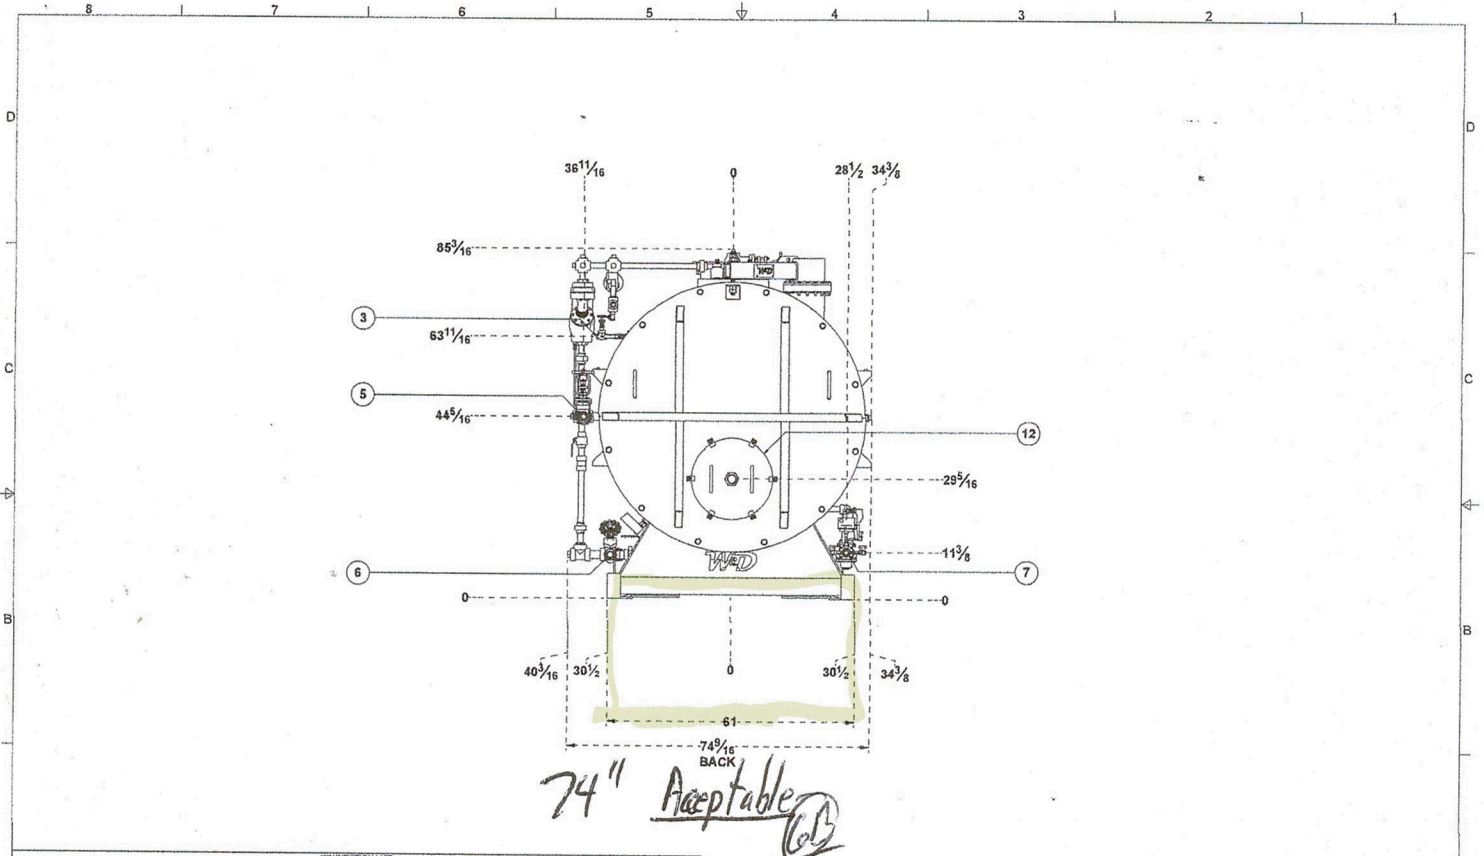

ITEM	DESCRIPTION	CONNECTION LIST	SIZE	MATERIAL	TYPE	QTY
Williams & Davis Boilers
 www.wdboiler.com

APPROVAL: (SIGN & DATE) MFG APPROVED BY PROJECT NO. PART NO. SCALE PER VIEW

DATE: 2/1/2021

REVISED: A

DESIGNER: HC

DESIGN DATE: 2/1/2021

CHECKED BY: DATE:

PROJECT NO: 4080D-150S-81770-SUB


PART DESCRIPTION: 4-PASS 80 HP DRY BACK, 150 PSI STEAM, SN 81770, TN: 2459247.45236.12

DATE: 2/1/2021

SCALE: 1/2" = 1'-0"

PER VIEW

Cy Mc 2/9/21

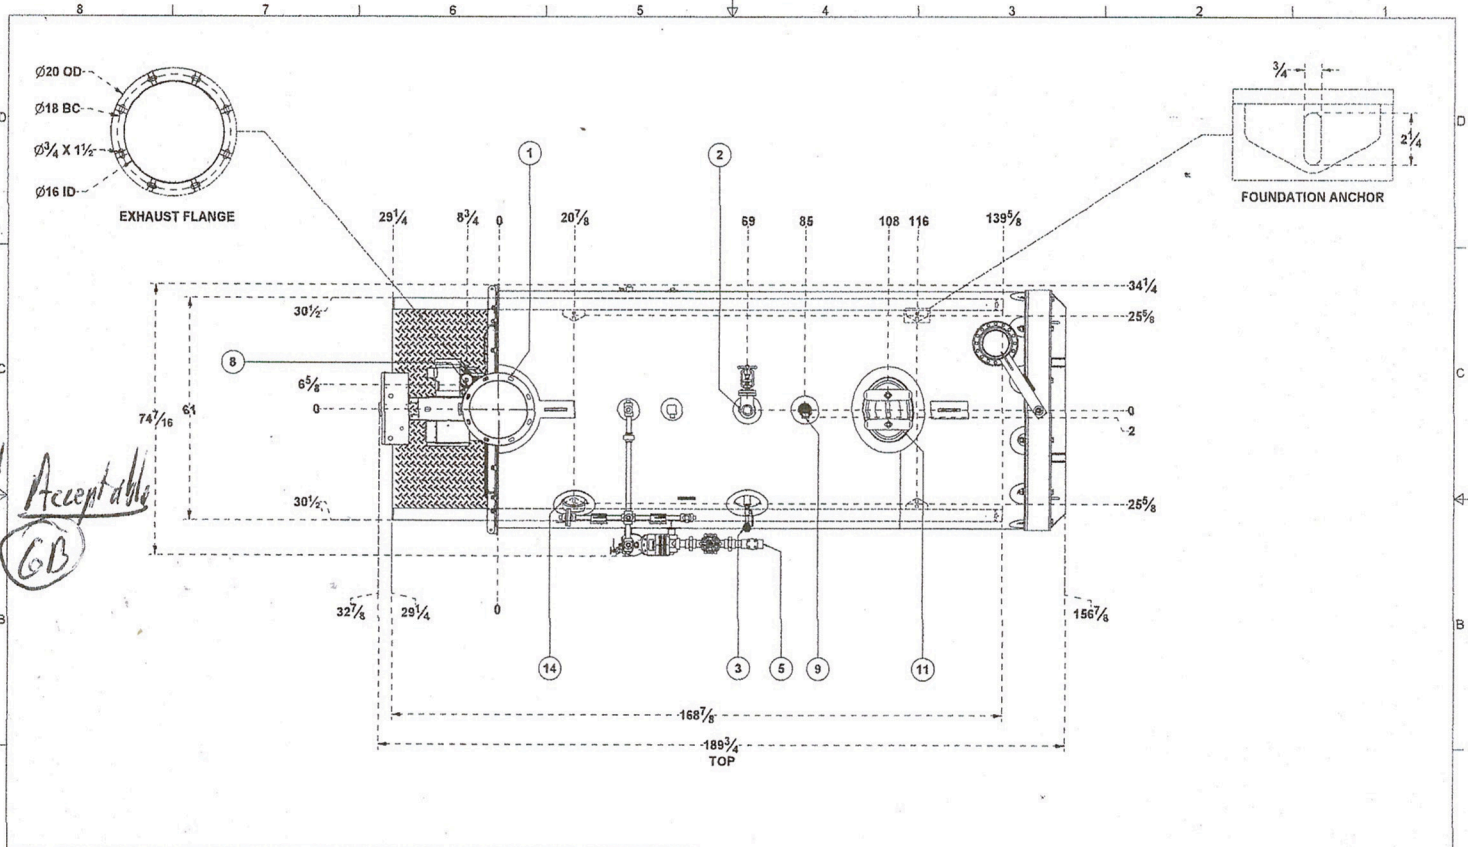

74" Acceptable
 GB


ITEM	DESCRIPTION	CONNECTION LIST	SIZE	TYPE	QTY
1	EXHAUST OUTLET TO OUTSIDE ATM		16"	WELD FLANGE	

Williams & Davis Boilers
 4080D-150S-81770-SUB
 4-PASS 80 HP DRY BACK, 150 PSI STEAM, SN 81770, TN: 2459247.45236.12

APPROVAL (SIGN & DATE): MFG APPROVED BY: PROJECT NO.: 81778
 MFG APPROVED DATE: SCALE: PART DESCRIPTION:
 PER VIEW

DRAWING NO.: 4080D-150S-81770-SUB
 REVISION: A
 DWG BY: HC
 DWG DATE: 2/1/2021
 CHECKED BY: DATE:

Cy Ru 2/9/21

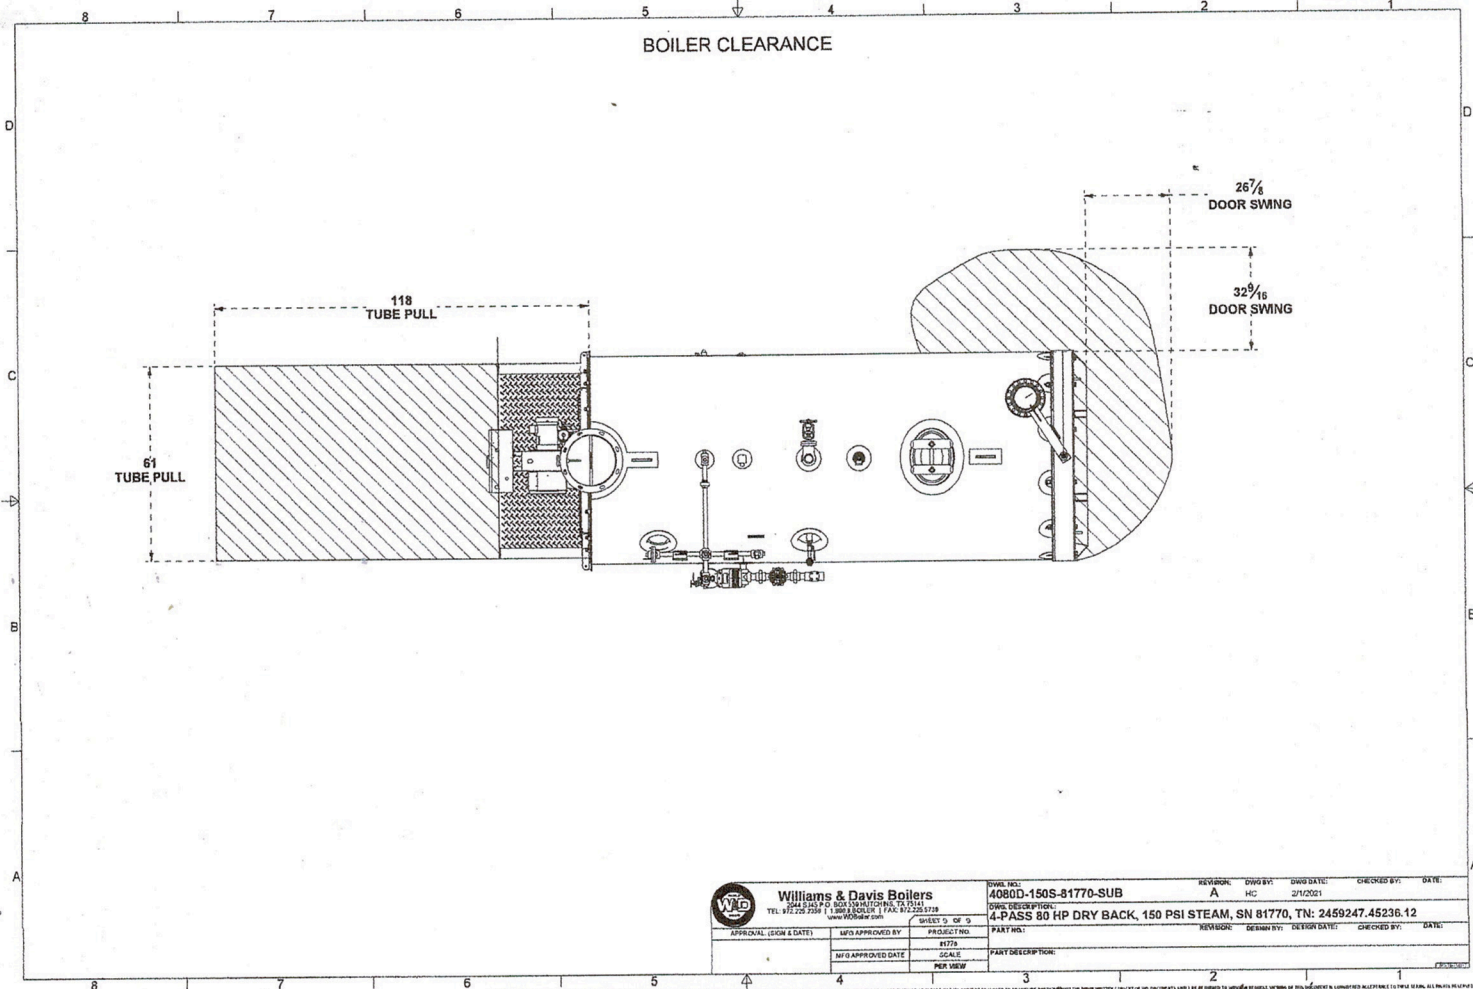

Williams & Davis Boilers
 www.wdboiler.com

DWG. NO.: 4080D-150S-81770-SUB	REVISION: A	DWG. DATE: 2/11/21	CHECKED BY:	DATE:
PART DESCRIPTION: 4-PASS 80 HP DRY BACK, 150 PSI STEAM, SN 81770, TN: 2459247.45236.12		DESIGN BY:	DESIGN DATE:	CHECKED BY:
APPROVAL (SIGN & DATE)	INFO APPROVED BY	PROJECT NO.	PART NO.:	
			81770	
	W/D APPROVED DATE	SCALE	PART DESCRIPTION:	
		PER VIEW		

GJK 2/9/21