1 SITE PLAN

SCALE 1"=20'-0"

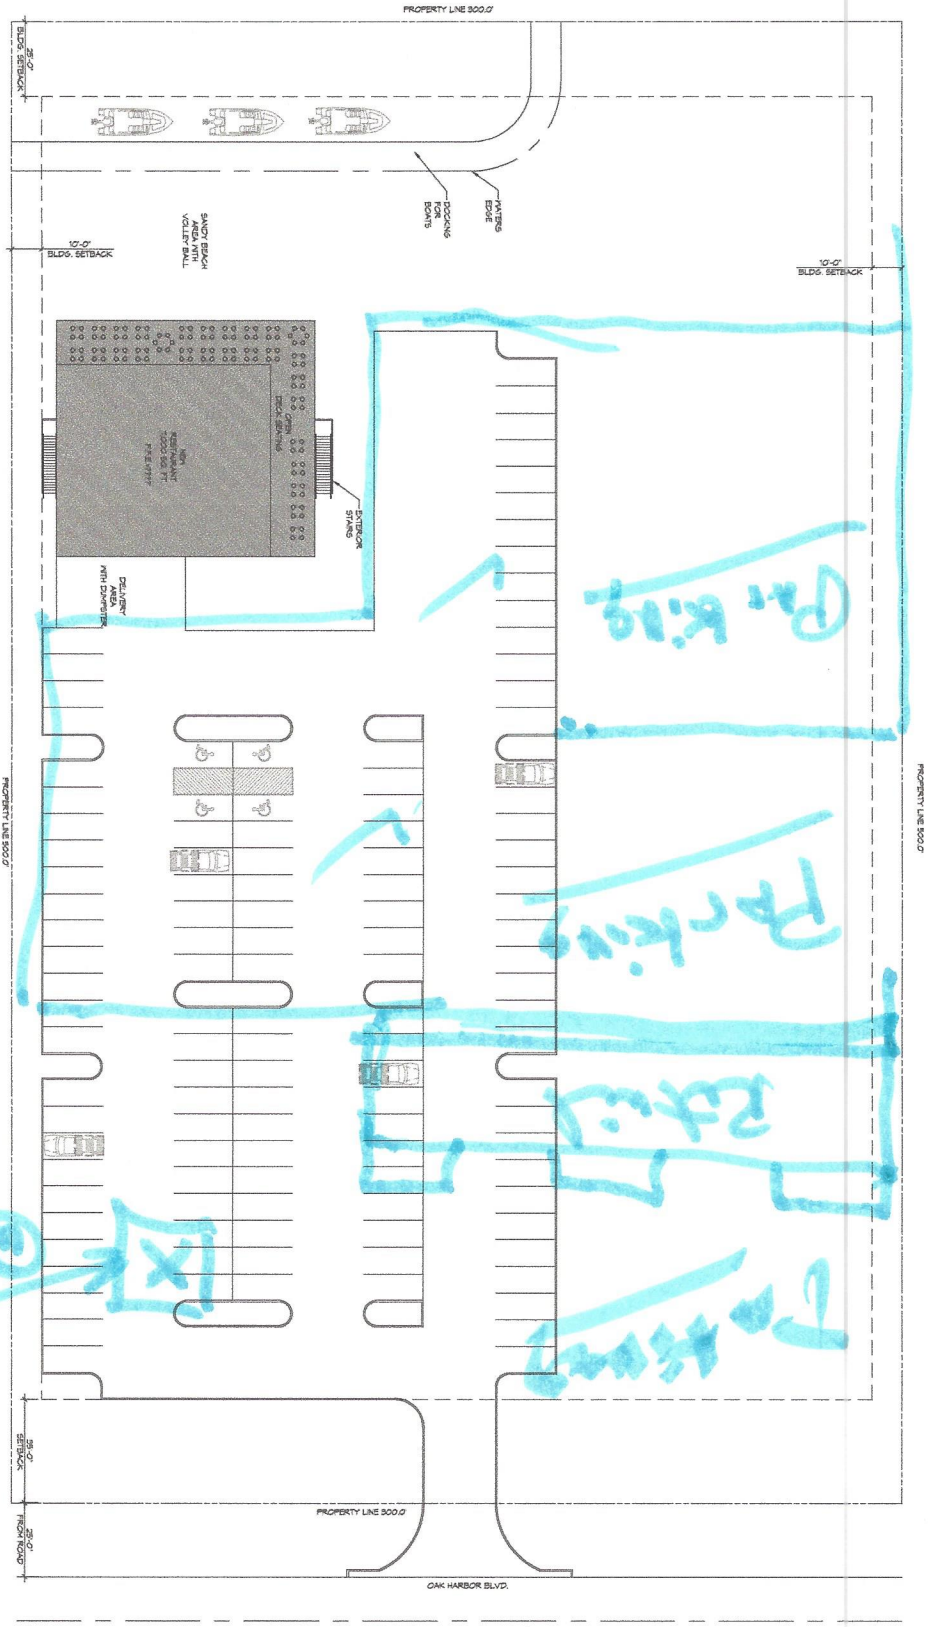

Parking

Parking

Parking

Parking @ Bar

NEW RESTAURANT

EQUITY

Larry Hale Sr.
Slidell, La. 70458

JOB No:	-	DATE:	07-15-2016
DRAWN BY:		CHECKED BY:	

The plant drawings and specifications, designs and arrangements represented shall not be used by any person, firm or corporation for any purpose whatsoever, nor shall they be loaned, copied or exhibited to others, or used in connection with any work or project other than the specific project for which the have been prepared and developed without written consent of DAMMON ENGINEERING, INC. Visual contact with these drawings and specifications shall constitute prima facie evidence of acceptance of these restrictions.

SEAL:

REVISIONS

#	DESCRIPTION	DATE

DAMMON ENGINEERING, INC.
LOUISIANA & MISSISSIPPI
Chief Engineer: Brian Mutich, PE
554 Old Spanish Trail
Slidell, LA 70458
www.dammonengineering.com
info@dammonengineering.com
PH: 985.649.5832 F: 985.641.5950

SHEET TITLE: SITE PLAN

DRAWING NUMBER: C101

SHEET No: 3 of 23