
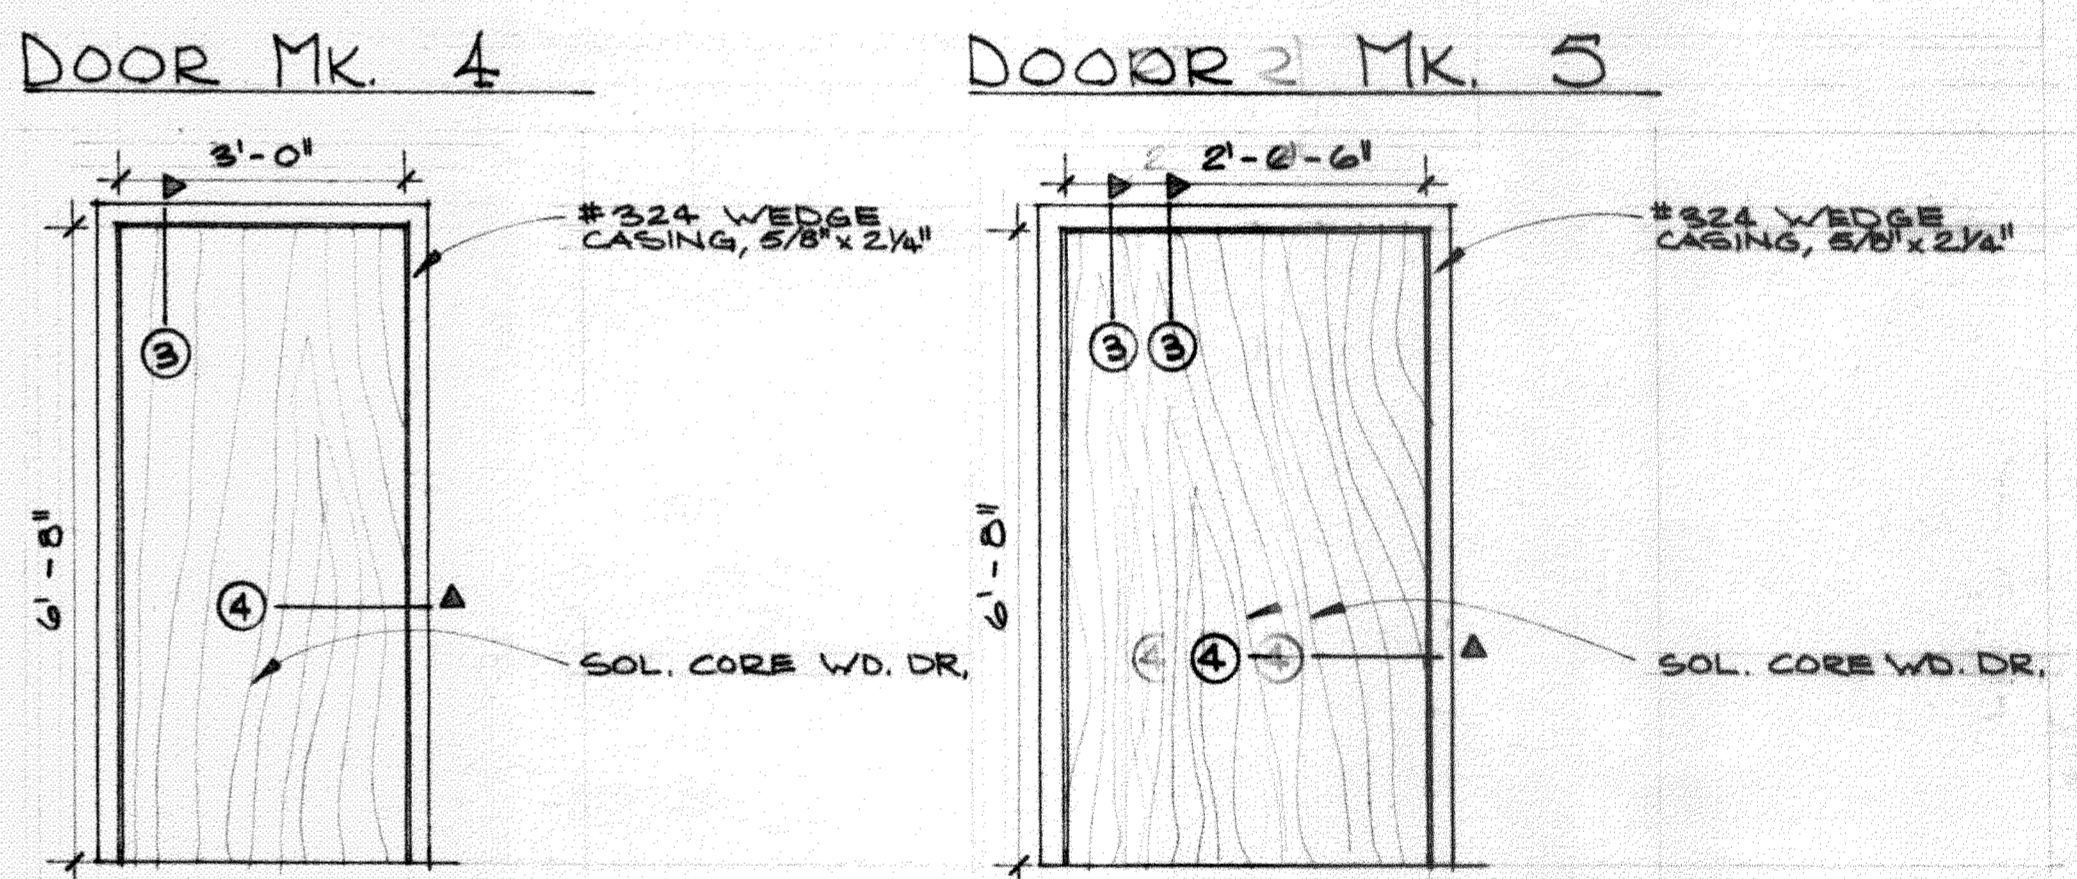


O P N I N G S		S C H E D.	
MK.	SIZE	DESCRIPTION	REMARKS
1	1 1/2" x 2'-0" x 6'-8"	EXT. FLUSH HOL. MET. DR. IN IN HOL. MET. FR. W/ ENTRY L.C. LOCK CK	VARCO-PRUDEN STD. DR. PROVIDE PANIC HDW., AUTO CLOSER, THRESH., WEATHERSTRIPING
2	1 1/2" x 2'-0" x 6'-8"	1/2" LITE	"
3	1 1/2" x 2'-0" x 6'-8"	1/2" LITE	"
4	1 1/2" x 2'-0" x 6'-8"	FLUSH SOL. CR. INT. W/D. DR. IN IN SOL. CORE W/D. DR. IN W/D. FRAME W/ PASSAGE SB LOCK CK	20 MIN. LABEL W/ AUTO CLOSER
5	1 1/2" x 2'-0" x 6'-8"	FLUSH SOL. CR. INT. W/D. DR. IN IN SOL. CORE W/D. DR. IN W/D. FRAME W/ PASSAGE SB LOCK CK	1 HR. "B" LABEL W/ AUTO CLOSER
6	1 1/2" x 2'-0" x 6'-8"	FLUSH SOL. CR. INT. W/D. DR. IN IN SOL. CORE W/D. DR. IN W/D. FRAME W/ PASSAGE SB LOCK CK	PROVIDE PRIVACY LOCKSET AT RM. 105, 106 & 108
7	1 1/2" x 2'-0" x 6'-8"	FLUSH SOL. CR. INT. W/D. DR. IN IN SOL. CORE W/D. DR. IN W/D. FRAME W/ PRIVACY LY LOCK CK	"
A	3'-0" x 6'-0"	DBL. GLAZED HORIZ. SLIDING ALUM. W/D.W.	VARCO-PRUDEN STD. W/D.W.
B	3'-0" x 6'-0"	SING. GLAZED HORIZ. SLIDING ALUM. W/D.W.	MAYFAIR W/ 1/4" WIRE GLASS

OPENING NOTES:
 1. EXT. ALUM. THRESHOLDS TO BE H/C TYPE, E. MAX. 1/2" HIGH, EXT. CONCRETE TO BE LEVEL W/ INT. FLOOR AT DOORWAY.
 2. ALL DOORS TO HAVE THREE HINGES.

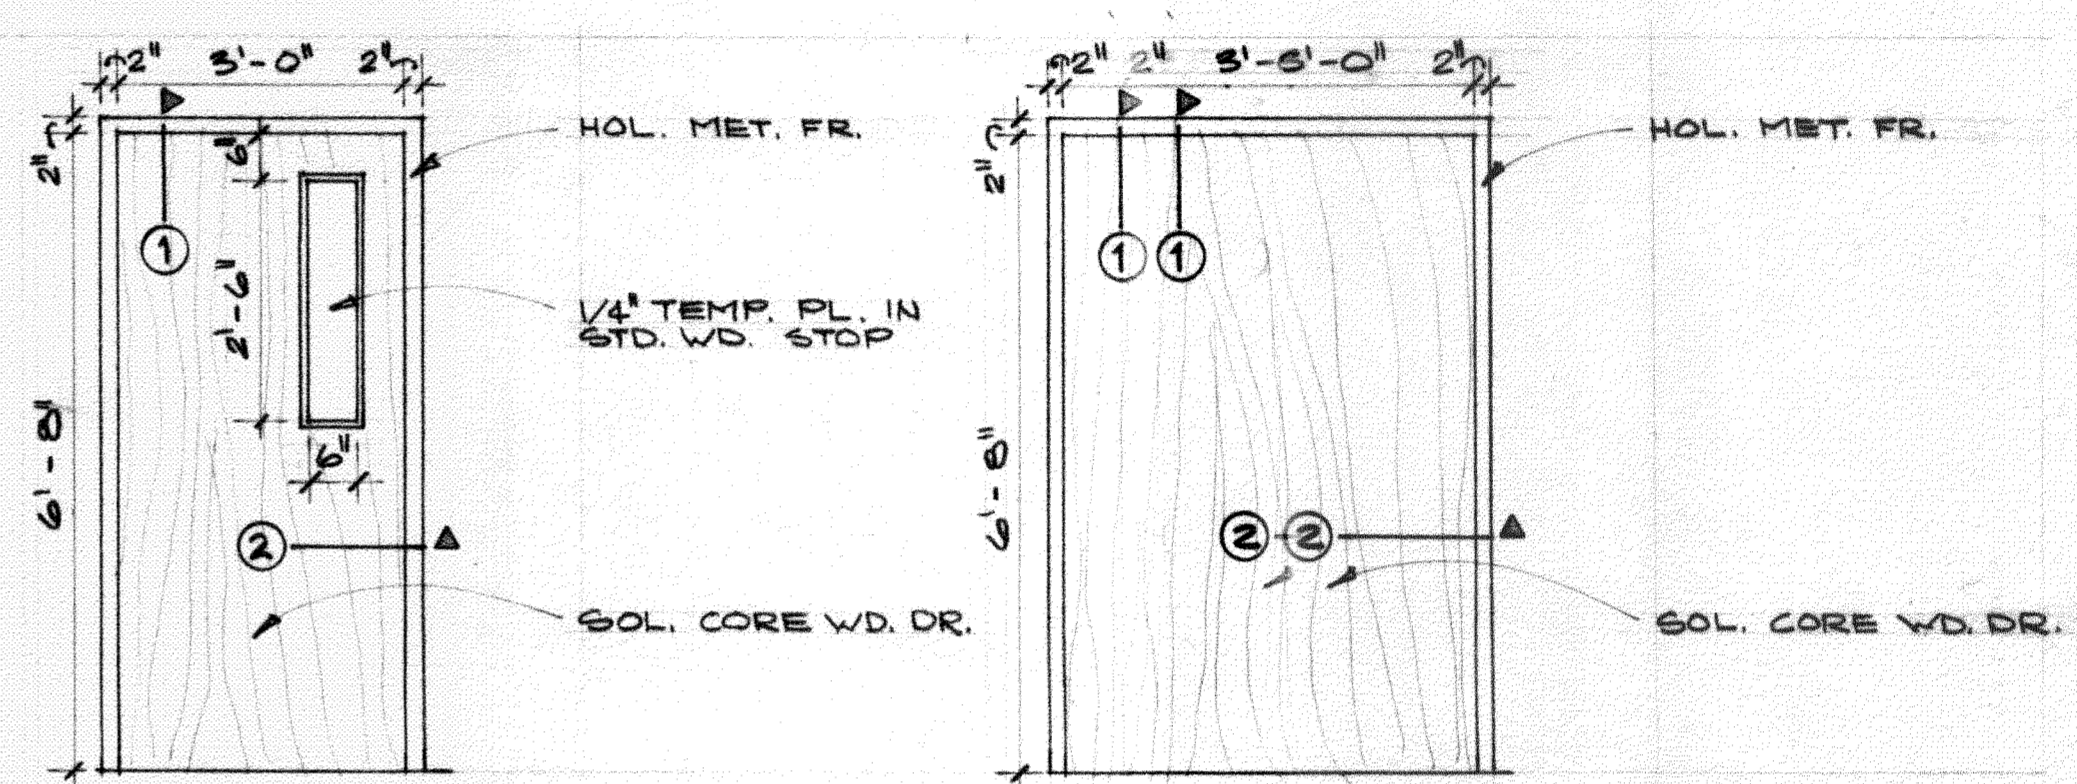

INTERIOR DOORWAYS
 OPENING DETAILS - SEE SHT. 15
 ONE HALF INCH EQUALS ONE FOOT

DIVISION 2 - SITEWORK
 PROVIDE ROUGH GRADING FOR WORK UNDER THIS CONTRACT AND FINISH GRADING FOR ENTIRE PROJECT. PROVIDE LANDSCAPING AS SHOWN ON PLANS IN COMPLIANCE WITH AND TO MEET THE FINAL APPROVAL OF THE ST. TAMMANY PARISH DEPARTMENT OF DEVELOPMENT. SEEDING AND LAWN WORK PROVIDED BY OWNER. MAINTAIN AND LANDSCAPE WORK FOR 90 DAYS INCLUDING WATERING, CULTIVATING, REGRADING AND REPLACEMENT, ETC. AS REQUIRED.

DIVISION 6 - CARPENTRY
 COMPLY WITH "MANUAL OF HOUSE FRAMING" BY NFPA. ALL FRAMING TO BE NO. 2 K.D. SOUTHERN PINE. ALL TRIM TO BE PAINT GRADE, SANDED WITH FASTENERS SET AND FILLED. CABINET WORK TO COMPLY WITH "ARCHITECTURAL WOODWORK QUALITY STANDARDS" BY AWI. ALL COMPLY WITH S.E. SERIES STANDARDS 400 FOR PLASTIC LAMINATE COUNTERTOPS AND ECONOMY GRADE CABINETS. ALL PLYWOOD TO BE A/C GRADE SOFTWOOD IN THICKNESSES AS SHOWN ON PLANS. METAL SHELF SUPPORTS TO BE K&V NO. 255 AND NO. 256, HINGES TO BE YOUNGDALE NO. 4 3/8" INSET SELF CLOSING HINGE FOR OVERLAY DOOR OR WITH NICKLE FINISH, DRAWER GLIDES TO BE NO. 3211 MEPLA FULL EXTENSION BOTTOM MOUNTED ROLLER GUIDES WITH WHITE FE FINISH, ALL PULLS TO BE STANLEY NO. 4483, COAT HOOKS TO BE STANLEY NO. SP7082, ZINC PLATE FINISH. TREATED WOOD TO COMPLY WITH AWPB LP-2.

DIVISION 7 - INSULATION
 FIBERGLASS INSULATION TO BE EQUAL TO OWENS-CORNING UNFACED, IN THICKNESSES AS SHOWN ON PLANS.

DIVISION 8 - DOORS
 COMPLY WITH STEEL DOOR INSTITUTE RECOMMENDED SPECIFICATION (SDI-100). HOLLOW METAL FRAMES TO BE EQUAL TO STEELCRAFT CO. 16 GAUGE, KNOCK DOWN TYPE, FACED/RY PRIMED, PREPARED FOR HARDWARE WITH SILENCERS AND APPROPRIATE ANCHORS. WOOD DOORS TO BE EQUAL TO MOHAWK, SEVEN PLY CONSTRUCTION FLUSH DOORS, STANDARD SOLID PARTICLE CORE OR MINERAL CORE AS REQUIRED, WITH STANDARD BIRCH FACE, B. WITH STANDARD FACTORY SIZING, PREPARED FOR FRAMES AND HARDWARE. HINGES TO BE STANLEY FULL MORTISE STANDARD WEIGHTIGHT BALL BEARING HINGES, DOOR STOPS TO BE IVES NO. 436 OR 407407 AS REQUIRED, AUTO CLOSER TO BE LCN NO. 1460. LOCKSETS TO BE SCHLAGE SATIN CHROME PLATED (626) D60PD ORBIT STYLE, MASTERKEYED, SEE OPENING SCHEDULE. PROVIDE TWO KEYS FOR EACH LOCK PLUS FOUR MASTERKEYS.

LAMINATED SAFETY GLASS TO BE 2 SHEETS 1/8" CLEAR FLOAT GLASS LAMINATED WITH 30 MIL PVB EQUAL TO PPG-5. POLISHED WIRE GLASS TO BE QUALITY 011, CLEAR DIAMOND MESH, 1/4" THICK, UL LABELED "FIRE RESISTANT" JT.

DIVISION 9 - FINISHES
 PROVIDE GYPSUM BOARD IN ACCORDANCE WITH ASTM C840 AND C846. PRODUCTS TO BE EQUAL TO U.S. GYPSUM CO. PROVIDE ALL TRIM AND BEAD ACCESSORIES AS REQUIRED. ISOLATE AND PROVIDE PROPER SEALANT AT EDGES MEETING EXISTING SURFACES. INSTALL JOINT COMPOUND IN THREE COATS, SANDING AFTER LAST TWO COATS. ALL GYPSUM BOARD TO BE SCREWED TO SUBSTRATE.

PROVIDE NEW SUSPENDED ACOUSTICAL TILE CEILING SYSTEM IN COMPLIANCE WITH ASTM C635 AND C636 FOR HEAVY DUTY SYSTEM. CONFORM TO UL DESIGN R/C/T, 1 HOUR FIRE RATED. SYSTEM TO BE WHITE ENAMEL ON STEEL INVERTED TEE, DIRECT HUNG. SCREW NEAR EDGE MOLDING TO SUBSTRATE AT 16" O.C. WITH MITERED CORNER JOINTS, CORNERS AT INTERSECTIONS. CEILING SYSTEM TOLERANCE 1/8" IN 12'-0". CEILING PANELS TO BE ONE HOUR FIRE RATED 24"x24"x5/8" LAY IN CONCRETE OR ROCK FACE OR ARMSTRONG ARMATUFF, AND IN KITCHEN CONNED METAL FACE NON-PERFORATED, ALL FLAME SPREAD 25 OR LESS, SMOKE DEVELOPED 50 OR LESS, UL LISTED. PROVIDE HOLD DOWN CLIPS AT ALL PANELS.

VINYL COMPOSITION FLOOR TILE TO BE ARMSTRONG IMPERIAL EXCELON, 12"x12"x1/8" ASBESTOS FREE. PROVIDE STANDARD VINYL WALL BASE 4" HIGH, 1/8" GAUGE. CONTRASTING COLOR STRIPS WILL BE USED IN THE CORRIDORS.

PREPARE AND CLEAN SURFACES AS REQUIRED FOR PAINT FINISH. PRIME AND PAINT WITH TWO FINISH COATS. PAINT MATERIALS TO BE EQUAL TO SHERWIN WILLIAMS AS FOLLOWS: GYP. BD./INT. WD. - SW PRO-MAR FLAT LATEX PRIMER, SW B31 SERIES PRO-MAR LATEX EX SEMI GLOSS ENAMEL - METAL - SW B40N2 KEM-KROMIK PRIMER, INTERIOR SW B34 SERIES PRO-MAR ALKYD SEMI GLOSS ENAMEL, EXTERIOR SW A40 SERIES CLASSIC 99 SEMI-GLOSS ENAMEL, TRAFFIC PAINT SW PRO-MAR TRAFFIC MARKING PAINT (YELLOW), NATURAL FINISH WOODWORK - SW A67F1 HAND RUBBED SATIN POLYURETHANE VARNISH, THINNED FIRST COAT WITH TWO FINISH COATS AS PER MANUFACTURERS RECOMMENDATION.

CARPET - ALLOW \$500.00 IN THE BID FOR PURCHASE AND INSTALLATION OF CARPET TO BE SELECTED BY OWNER.

METAL FACE WALL PANELS TO BE ALLIANCE WALL INTERIOR OR 28 39 GAUGE STEEL FACE PORCELAIN ENAMEL PANELS IN 1/2" OR 5/8" THICKNESS AS SHOWN ON PLANS WITH GYPSUM BOARD FIRE CODE "E" STABILIZER WITHOUT BACKING. INSTALL IN ACCORDANCE WITH MANUFACTURER'S RECOMMENDATION WITH SCREWS AND ADHESIVE. PROVIDE MANUFACTURERS STANDARD WARRANTY. INCLUDE ALL ACCESSORIES AND TRIM AS REQUIRED.

VINYL FACED GYPSUM PANELS TO BE UNITED STATES GYPSUM, "TEXTONE FIRE CODE" PANELS, RANGE "A" PUMICE, 1/2" IN

4-19-90

HEAD START CENTER AIRPORT RD. SLIDELL, LA

DAMMON ENGINEERING, INC. 1095 FLORIDA AVE. SLIDELL, LA 70458

3

CONT. SHT. 7