NOTE : ALL ROOF SYSTEM ANCHORS TO EXIST'G. DECK MATERIALS MUST BE SUBMITTED FOR APPROVAL IN SAMPLE FORM, ACTUAL STYLE, WITH SUPPORTING ALLOY INFORMATION AND PULL-OUT DATA FOR EACH ANCHOR TYPE FOR EACH EXIST'G. DECK MATERIAL TO RECIEVE SUCH ANCHORS.

CONTRACTOR SHALL EXPOSE ALL EXIST'G. DECK AREAS TO RECIEVE ROOF SYSTEM ANCHORS FOR INSPECTION OF DECK CONDITION BY THE ARCHITECT.

CONTRACTOR MUST SUBMIT DESIGN CALCULATION, INCLUDING POST REACTIONS ON PROPOSED ROOF SYSTEM TO DESIGNER FOR REVIEW AND APPROVAL PRIOR TO FABRICATION. THIS IS NECESSARY TO VERIFY ADEQUACY OF ATTACHMENT DETAILS.

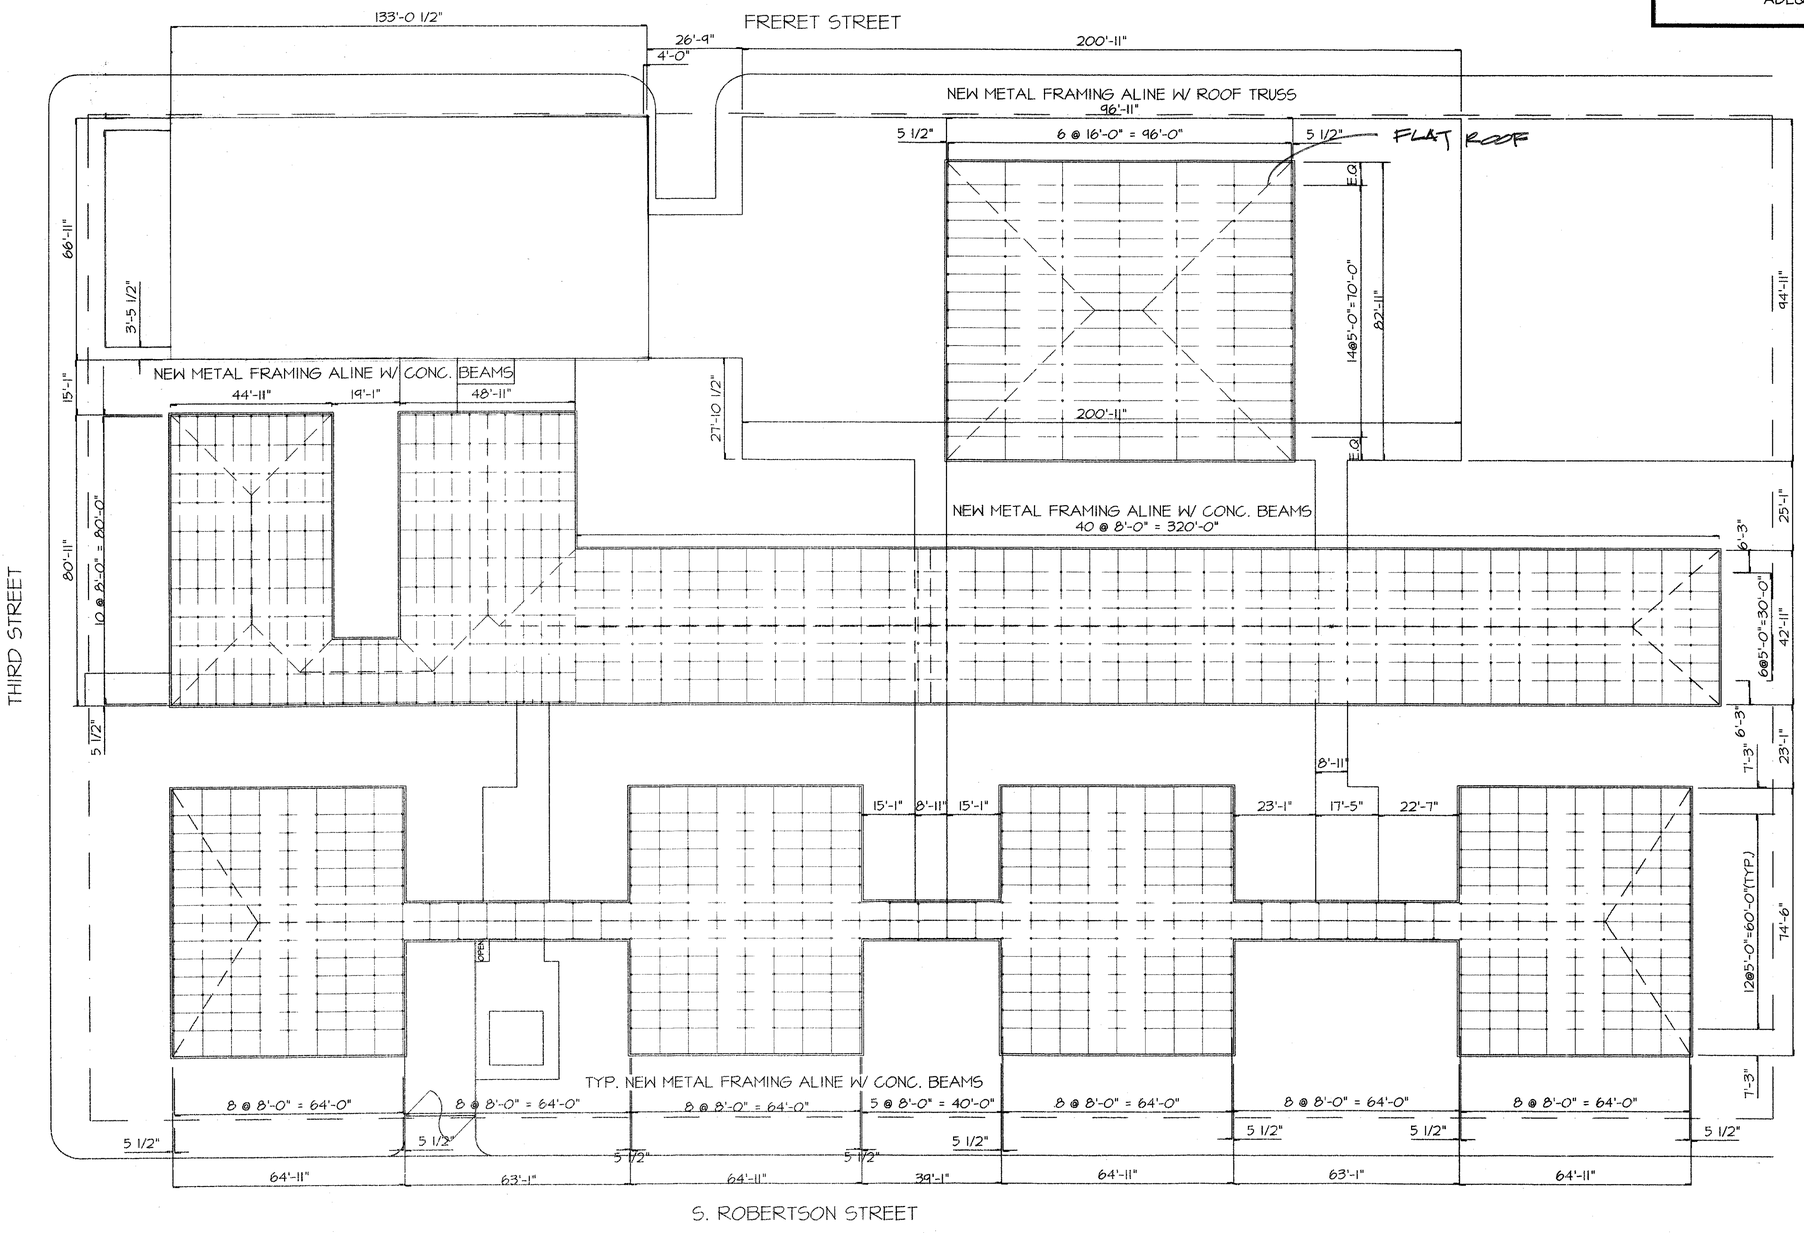

NEW METAL ROOF FRAMING PLAN
A-1 | A-12 1" = 20'-0"

SHOW NORTH ARROW

C:\SDSKPROJ\9602\A-12 Thu Feb 20 08:53:59 1997

CONSULTANT
BYRON J. STEWART & ASSOC.
ARCHITECTS & PLANNERS
2300 MARENGO ST.
NEW ORLEANS, LA 70115
(504) 897-5339

CLIENT
NEW ORLEANS PARISH SCHOOL BOARD
4300 ALMONASTER AVE
NEW ORLEANS, LA.

PROJECT
CARTER G. WOODSON JUN. HIGH SCHOOL
RE-ROOFING
F.D.P. # 92034

JOB NUMBER:	9602
DATE:	4-21-97
DRAWN BY:	M.A.
CHECKED BY:	B.J.S.

REVISIONS

NO.	DATE	REVISION

SHEET
A-13
OF SHEETS