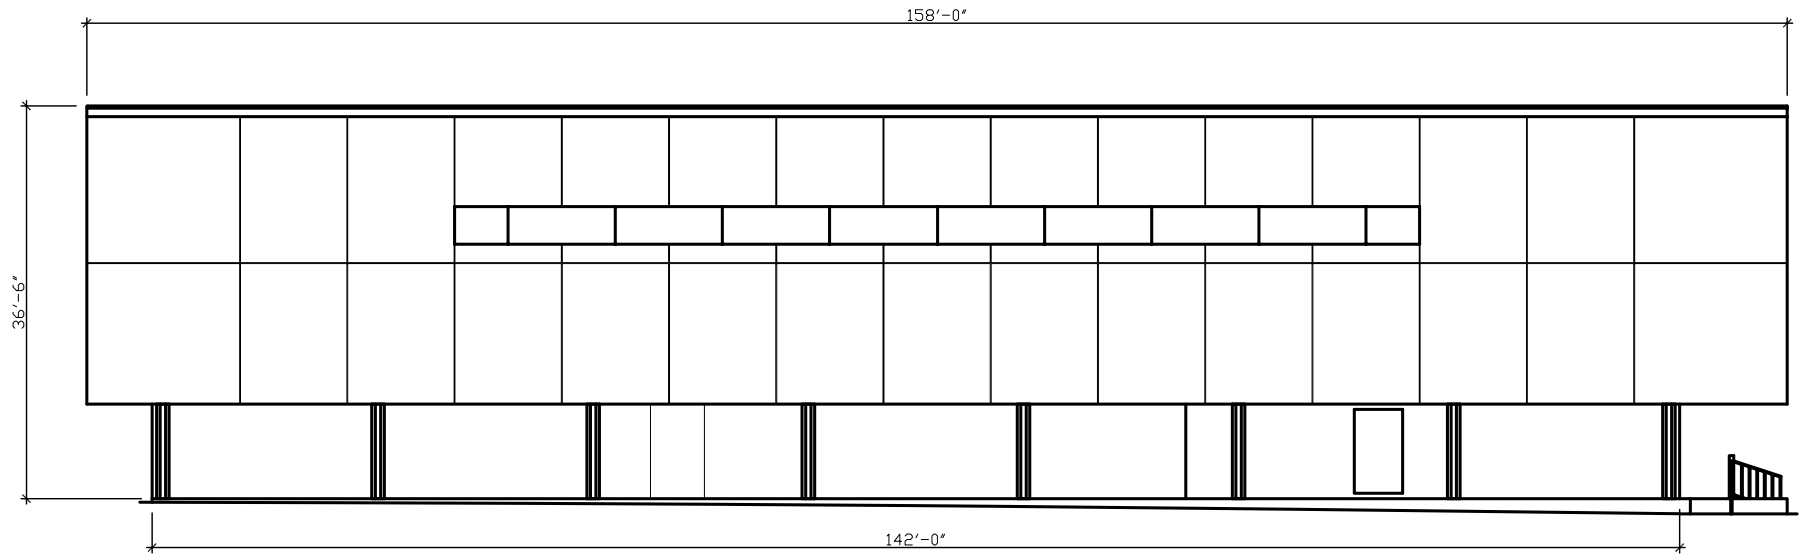

LEFT SIDE

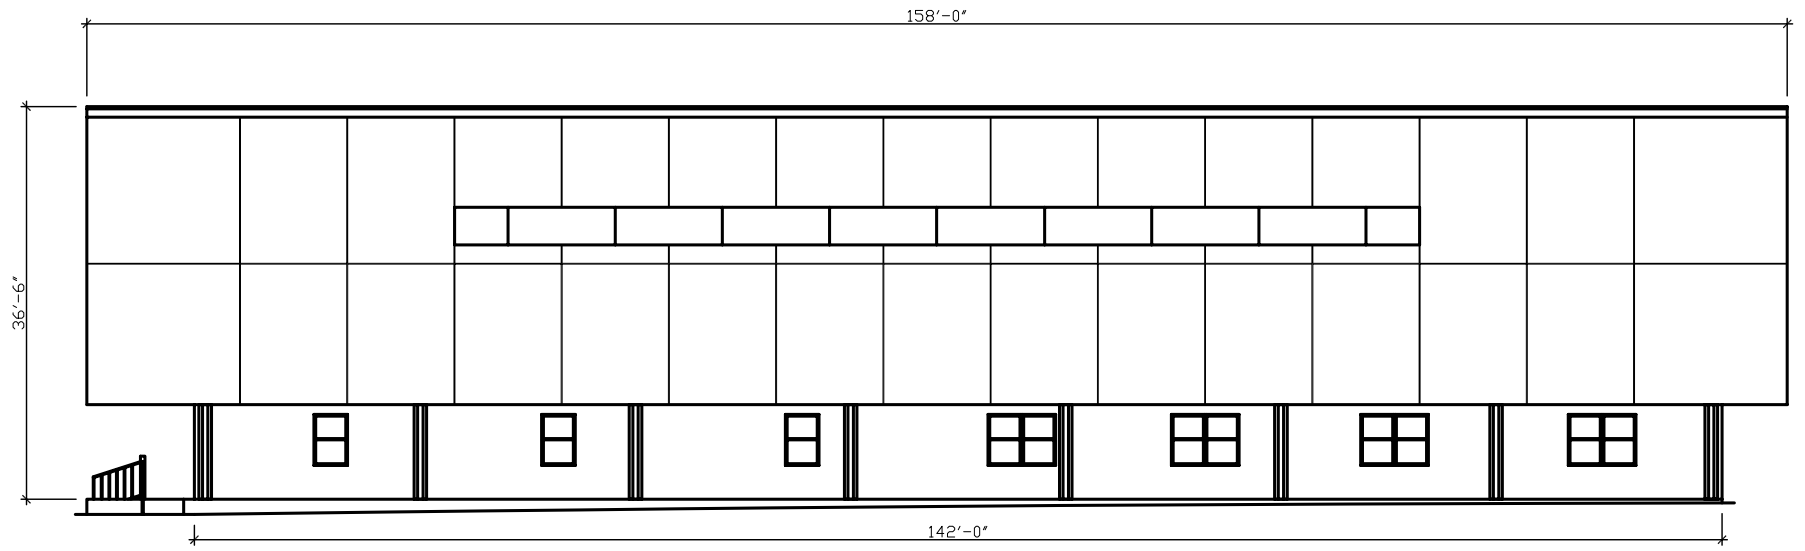

RIGHT SIDE

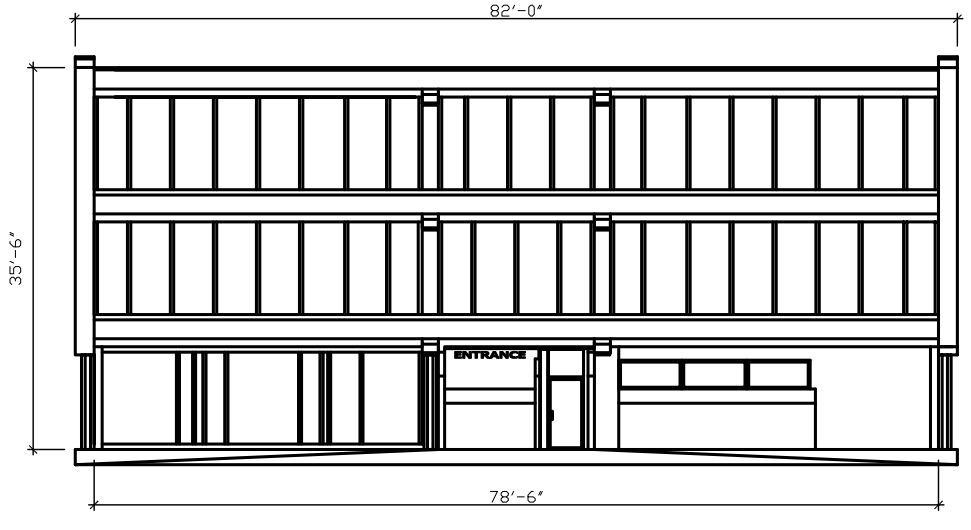

FRONT

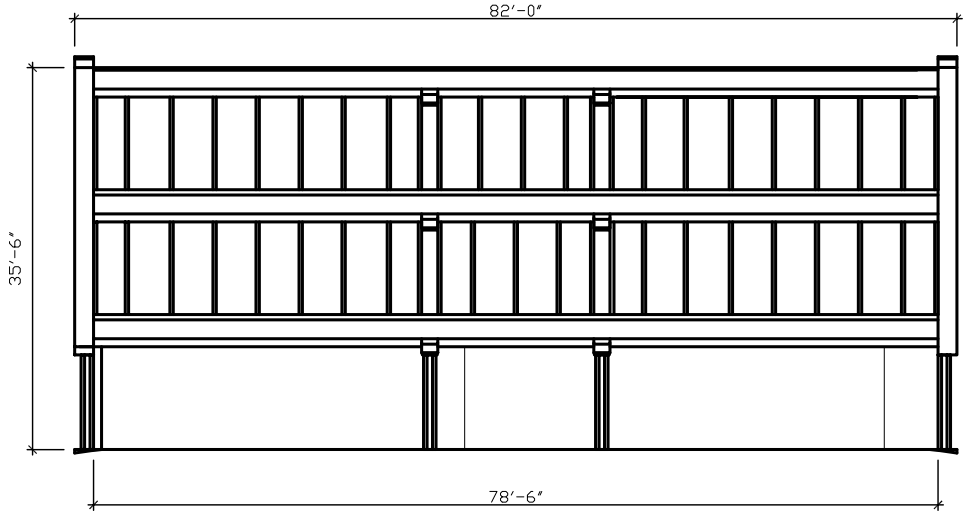

BACK

AS BUILT ELEVATIONS

SCALE 1/8"= 1'