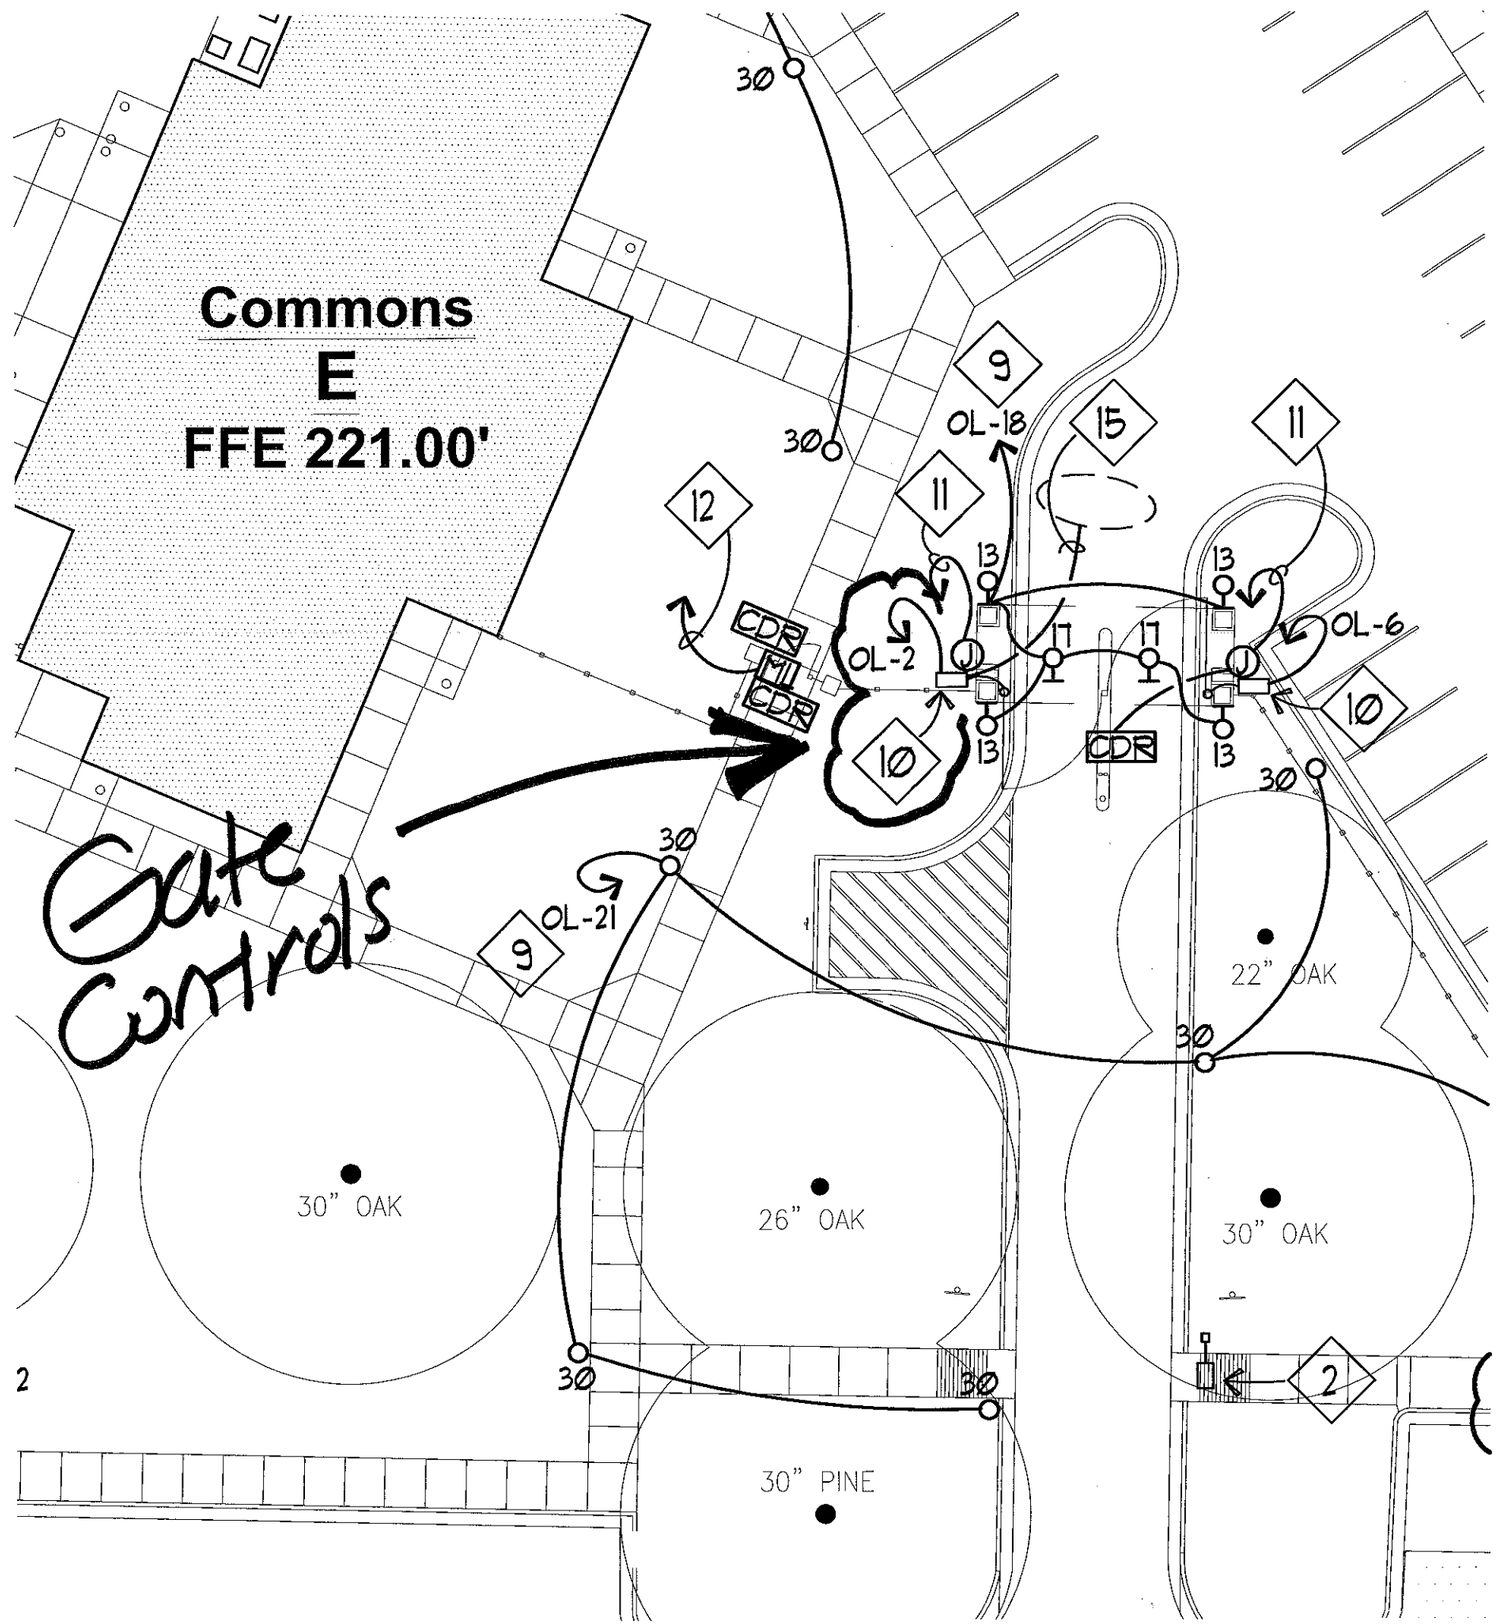
Commons
E
FFE 221.00'
Gate Controls
30
9
OL-18
15
11
12
13
CDR
MU
OL-2
17
OL-6
10
OL-21
22" OAK
30" OAK
26" OAK
30" OAK
30" PINE
2

Page 6 of 6