


a b c d e f g h k m p s t v w x y z aa ab ac ad ae af ag ah ak am ap as at av aw ax ay az ba bb bc bd be bf bg bh bk bm bp bs bt bv bw bx by bz

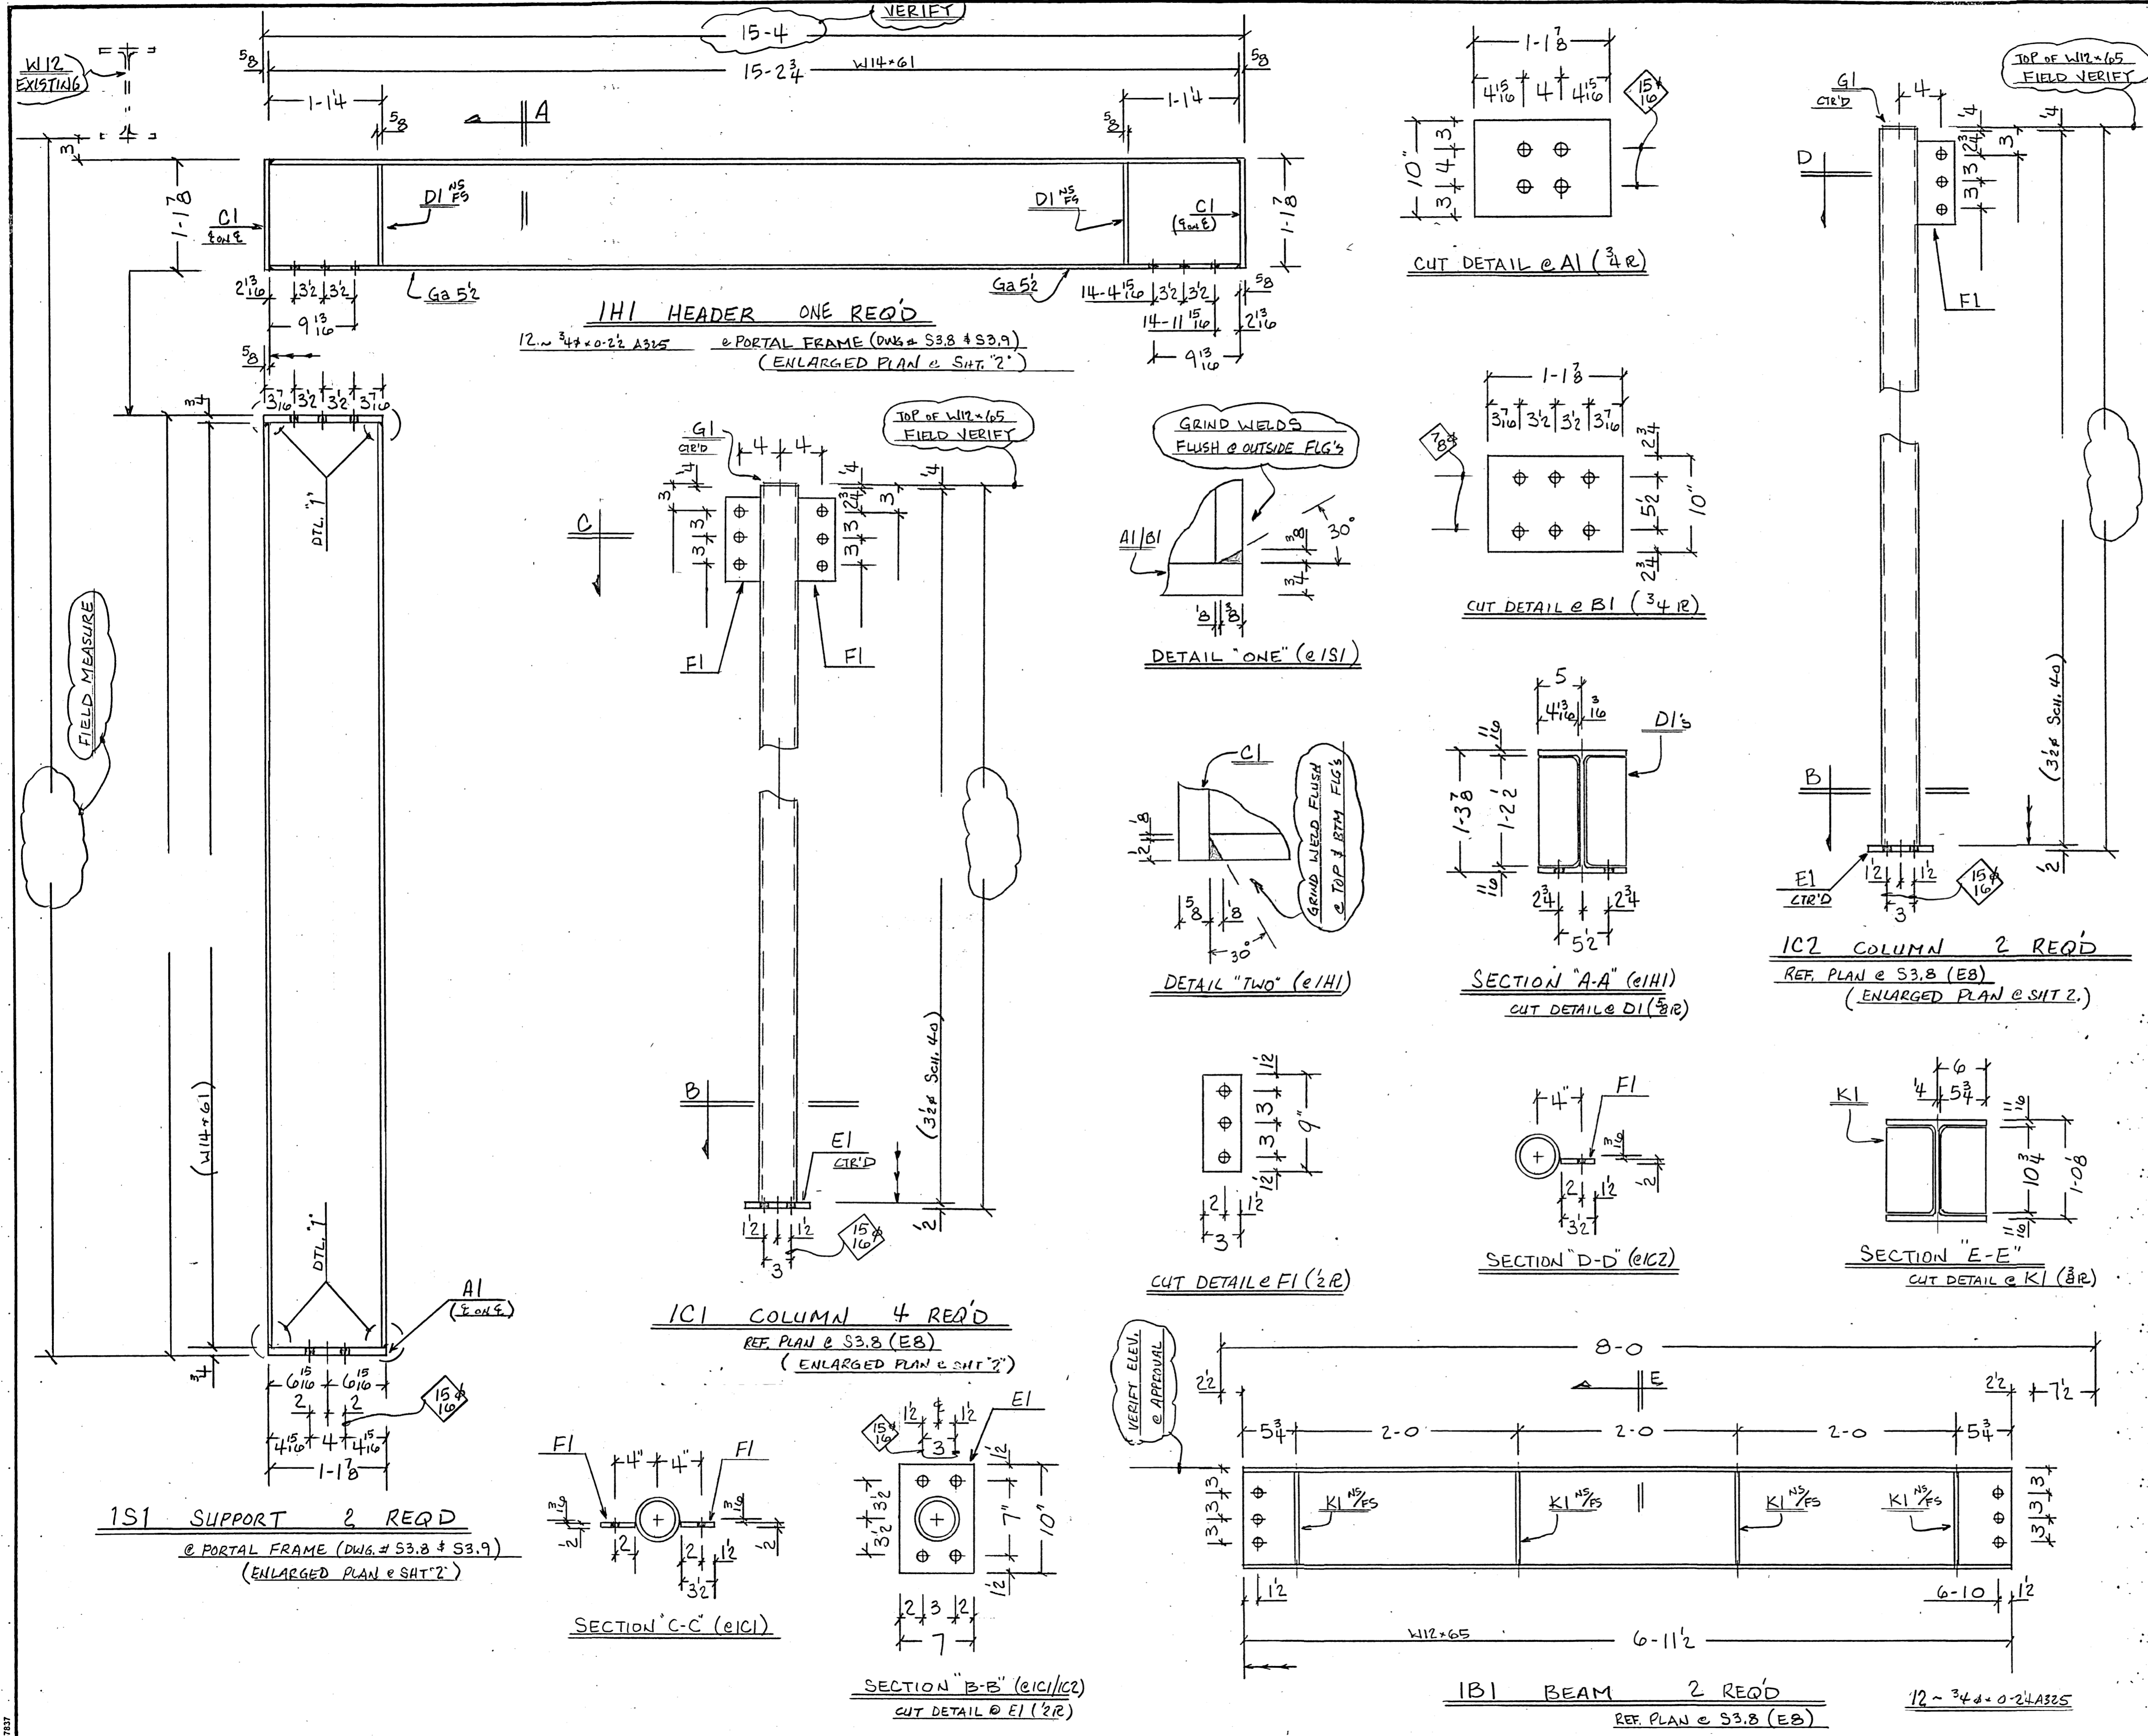

BILL OF MATERIAL SHOP ORDER

SHIP MARK	DATE NO.	DESCRIPTION	LENGTH		REMARKS	WT.
			FT.	IN.		
2	1S1	W14x61				
	A1 2	R3/4 x 10	1	17 1/8	15 1/4	
	B1 2	R3/4 x 10	1	17 1/8	7 1/2	
ONE	1H1	W14x61	15	2 3/4		
	C1 2	R5/8 x 10	1	17 1/8		
	D1 4	R3/4 x 4 1/2	1	2 1/2		
4	1C1	3 1/2 # SCH. 40				
	E1 4	R1/2 x 7	0	10	15 1/4	
	F1 8	R1/2 x 3 1/2	0	9		
	G1 4	R1/4 x 3 1/2 (O.D.)	0	3 1/2		
2	1C2	3 1/2 # SCH. 40				
	E1 2	R1/2	0	10		
	F1 2	R1/2	0	9		
	G1 2	R1/4	0	3 1/2		
2	1B1	W12x65	6	11 1/2		
	K1 16	R3/8 x 5 3/4	0	10 3/4		

Beam: ASTM A992
 Plate: ASTM A36
 Angle: ASTM A36
 Pipe: ASTM A53 Gr B

Verifications Req'd @ APPROVAL

1ST RELEASE

E1 = A3.8

ERECTOR BOLTS W/H.H.H. & H.H.N.				WASHERS		FINISH
QUAN.	SIZE	LENGTH	TYPE	FLAT	BEV	MILL
12	3/4"	0-2 1/2	A325	✓		
24	3/4"	0-2 1/4	do	✓		do

PIW Prairieville Iron Works

39041 James Drive
 Prairieville, LA 70769
 Phone 225 673 9372
 Email: prairievilleiron@yahoo.com

CUSTOMER: VOELKEL MCWILLIAMS LLC
 PROJECT: Add'l to MADISONVILLE ELEM.
 FOR: ST. TAMMANY PARISH SCH. BOARD
 LOCATION: MADISONVILLE, LA

ARCHT.-ENGR. _____
 CUST. P.O. NO. _____
 SURFACE PREP. PER SPEC
 OPEN HOLES 13 # 4.111.0
 WELDS 4 FILLET E70XX (U.N.O.)
 FINISH SHAP PRIME

DISTRIBUTION
 DRAWINGS OT DT BY
 APPROVAL
 FINAL APPR.
 SHOP
 FIELD
 FINAL DIST.
 REFERENCE DRAWINGS

DRAWN DJR
 CHECKED _____
 DATE 2050

DRAWING NUMBER 2050 / OF 10F

NO CHANGES WILL BE MADE ON OUR STEEL WHERE THERE ARE CHARGES WITHOUT WRITTEN APPROVAL.