


1

FLOOR PLAN - WGSO RADIO

1/16" = 1'-0" REVISION 40

UNIT 152
2710 CAUSE WEST

SPACE IS TAKEN PLAN IS MADE A MISTAKE

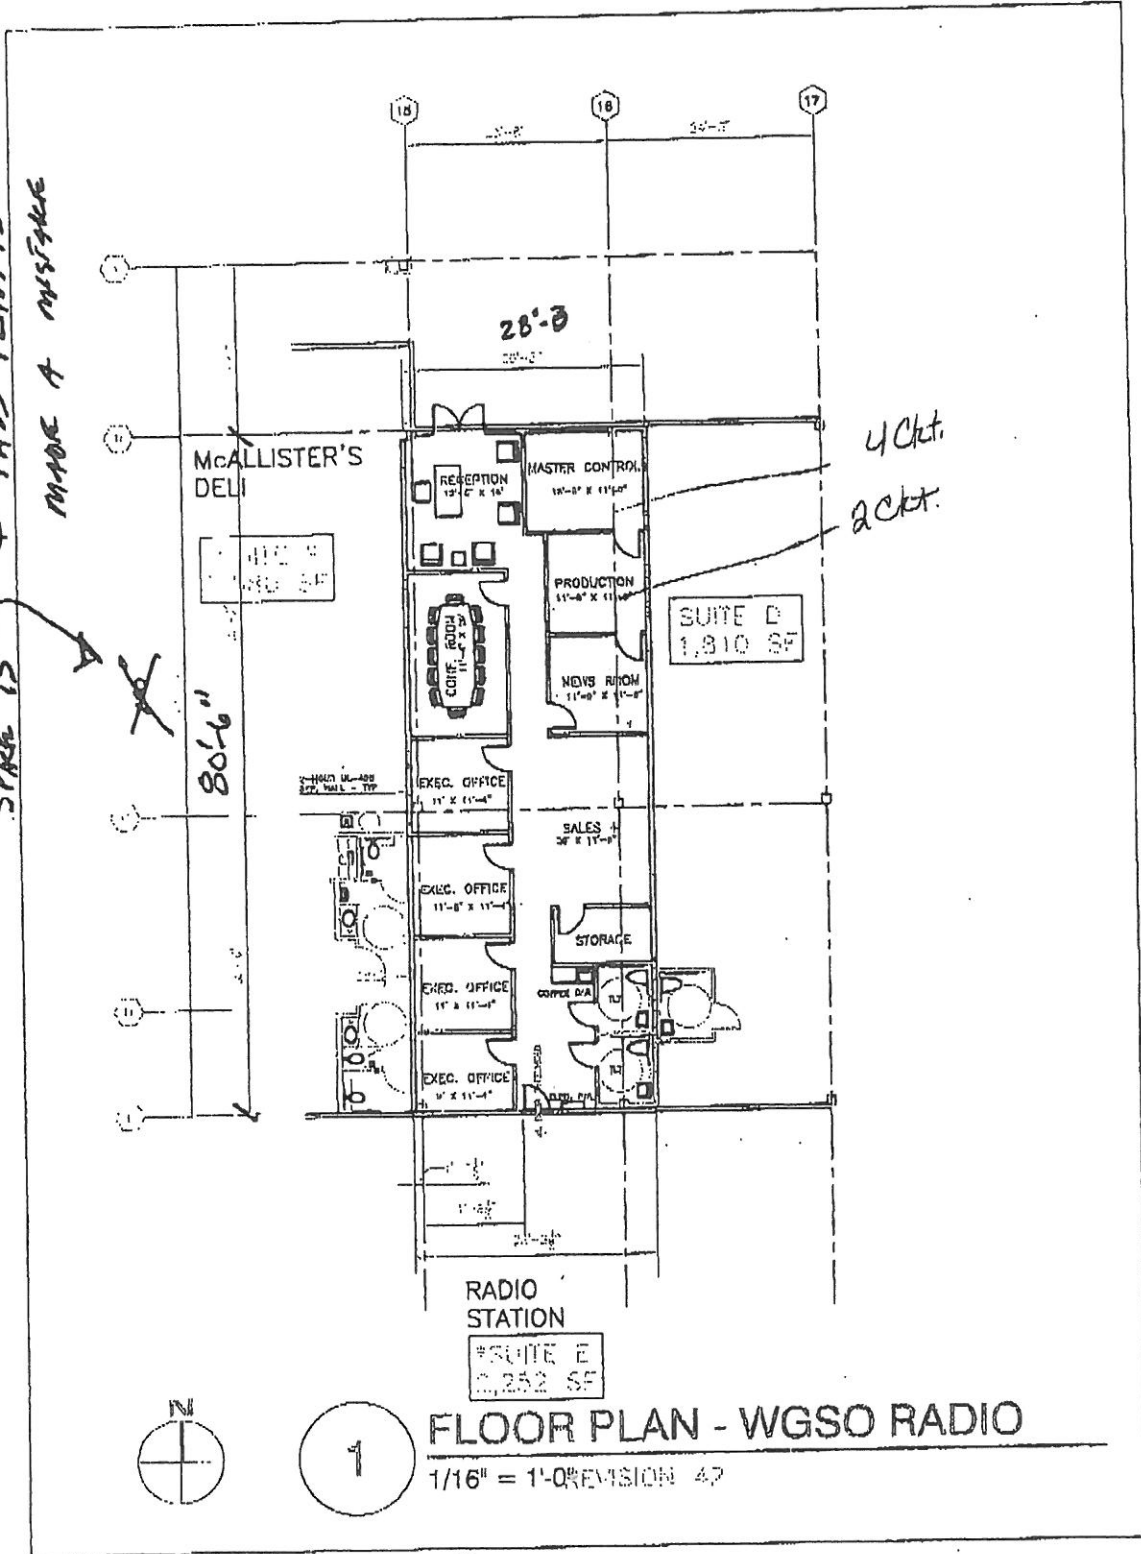


*UNIT 152
2710 CAUSEWAY WEST*

To: Chuck
 From Danny B

2 Pages

DANNY

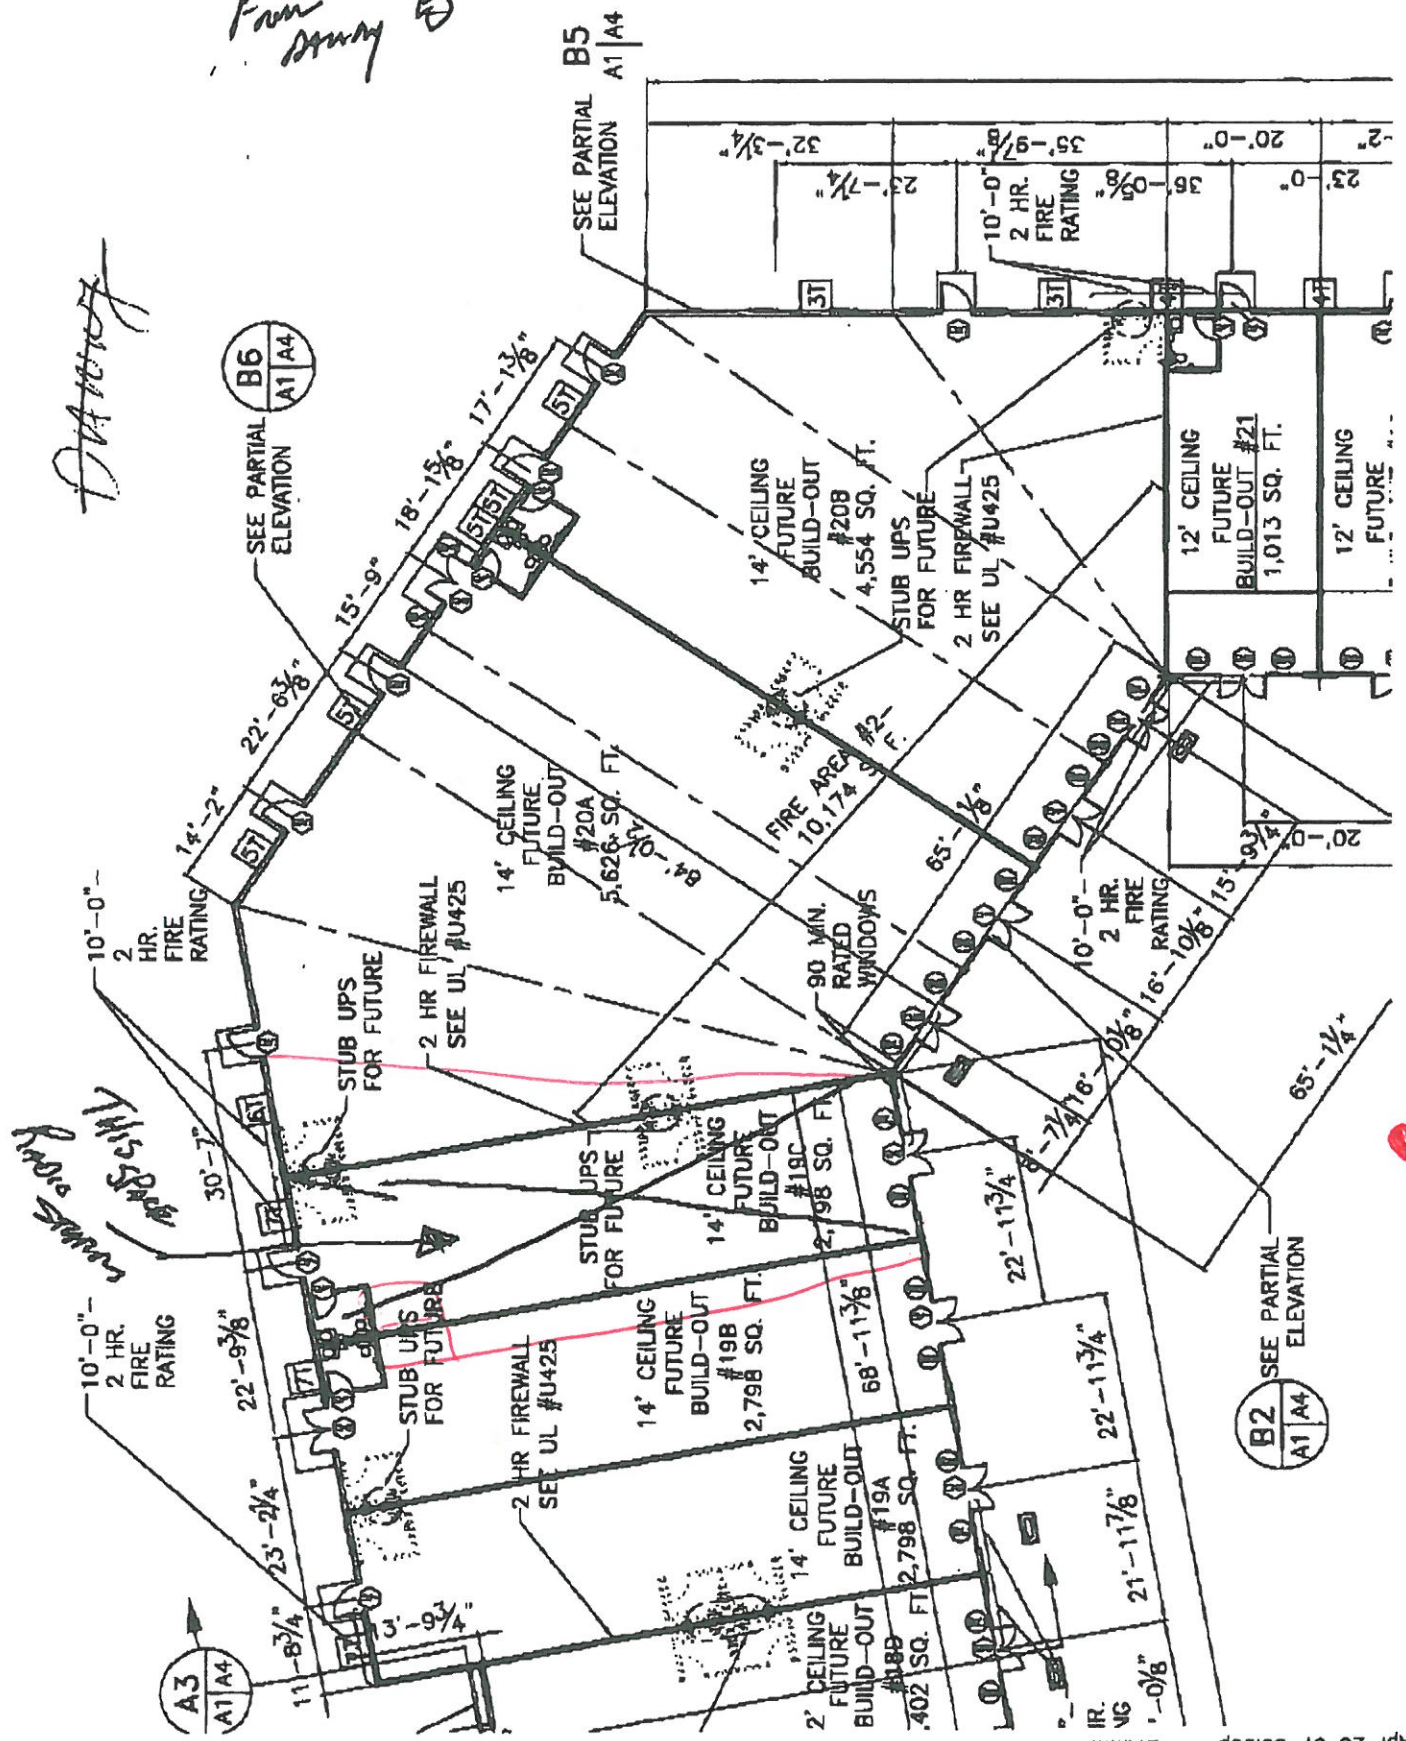

*This space
 Radio Station*

A3
 A1/A4

B6
 A1/A4
 SEE PARTIAL
 ELEVATION

B2
 A1/A4
 SEE PARTIAL
 ELEVATION

B5
 A1/A4
 SEE PARTIAL
 ELEVATION