

Dammon Engineering Inc.

1095 Florida Ave.
Slidell, LA 70458
(985) 649-5832
Fax: (985) 641-5950

FAX COVER SHEET

FAX NUMBER TRANSMITTED TO: 781-9819 (661-8399)
TO: Mania (Beckie)
FROM: Brandon
CLIENT/MATTER: Mini Storage
REFERENCE: _____
DATE: 7/5/07 NO. OF PAGES INCLUDING COVER SHEET: 2


COMMENTS:

Have Brian look this over before we go any further. Thanks.

Beckie,

This is the revised plan that was sent to Brian yesterday. (First floor is all that has changed)

IF YOU EXPERIENCE ANY PROBLEMS RECEIVING THIS FAX, PLEASE CALL (985) 649-5832, OR FAX (985) 641-5950

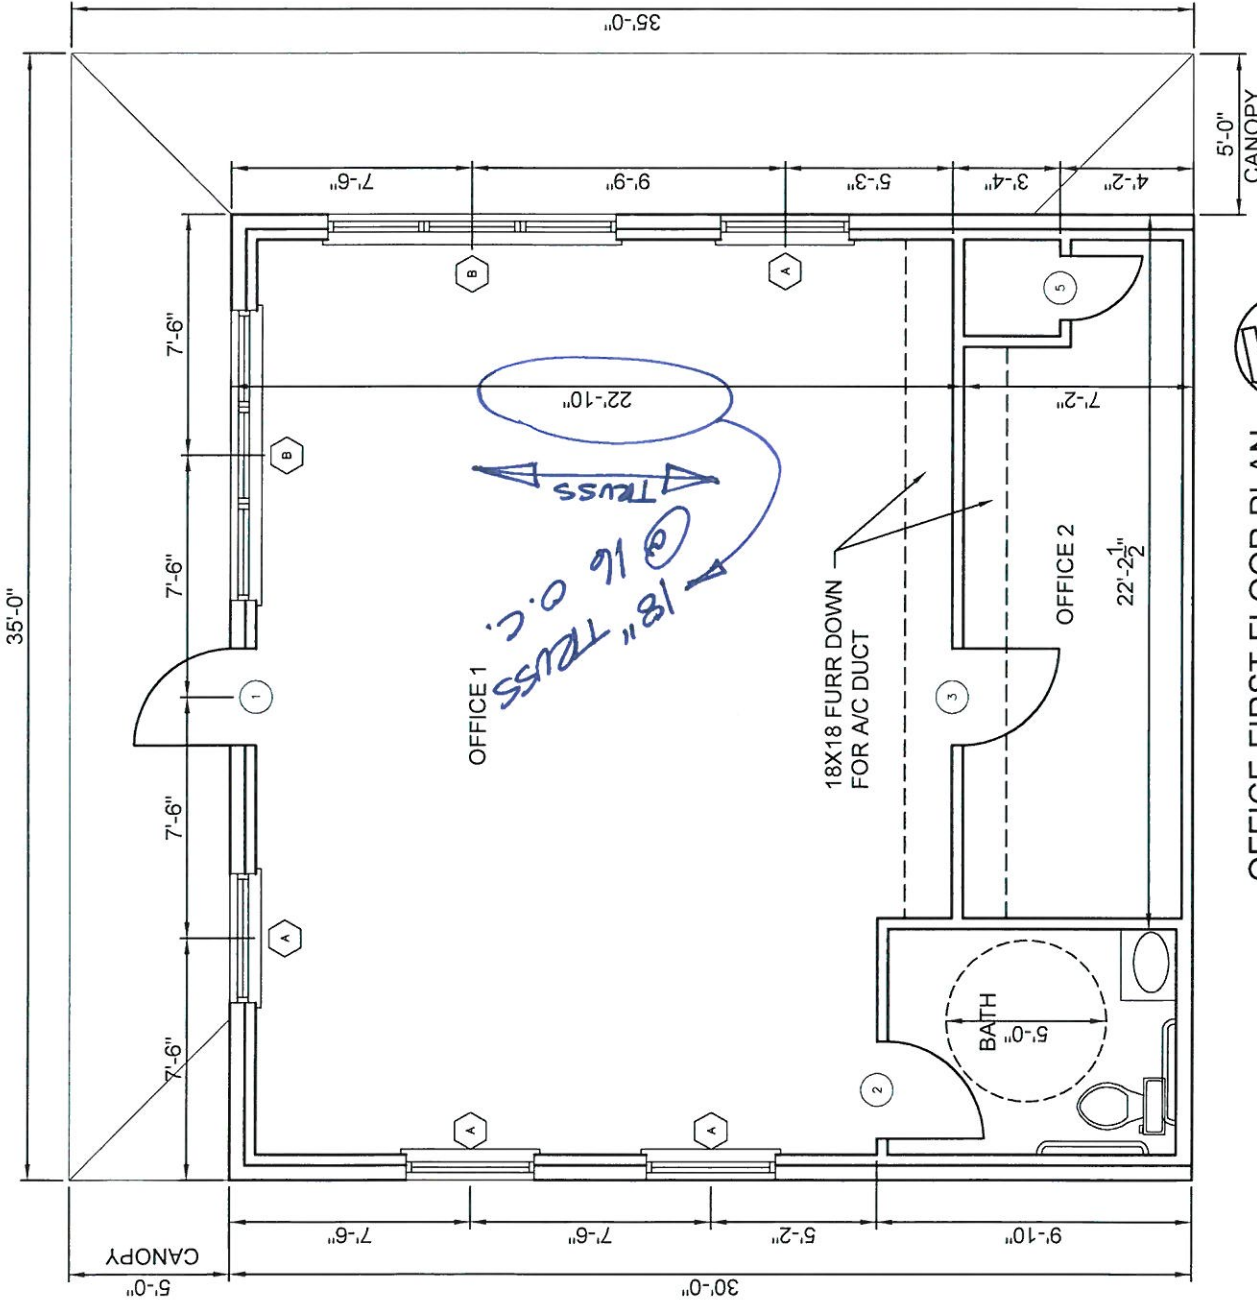


OFFICE FIRST FLOOR PLAN
SCALE: 1/2"=1'-0"


CLEO ROAD

Hwy 1090

CURB 1/4" DEEP
 SPACES @ 2" TO 3" O.C.
 SCORED INTO
 RETE AND PAINTED
 OF ALL RAMPS LEADING
 (CIRCULAR AREAS) MAX
 SCALE 1:12

LA HIGHWAY

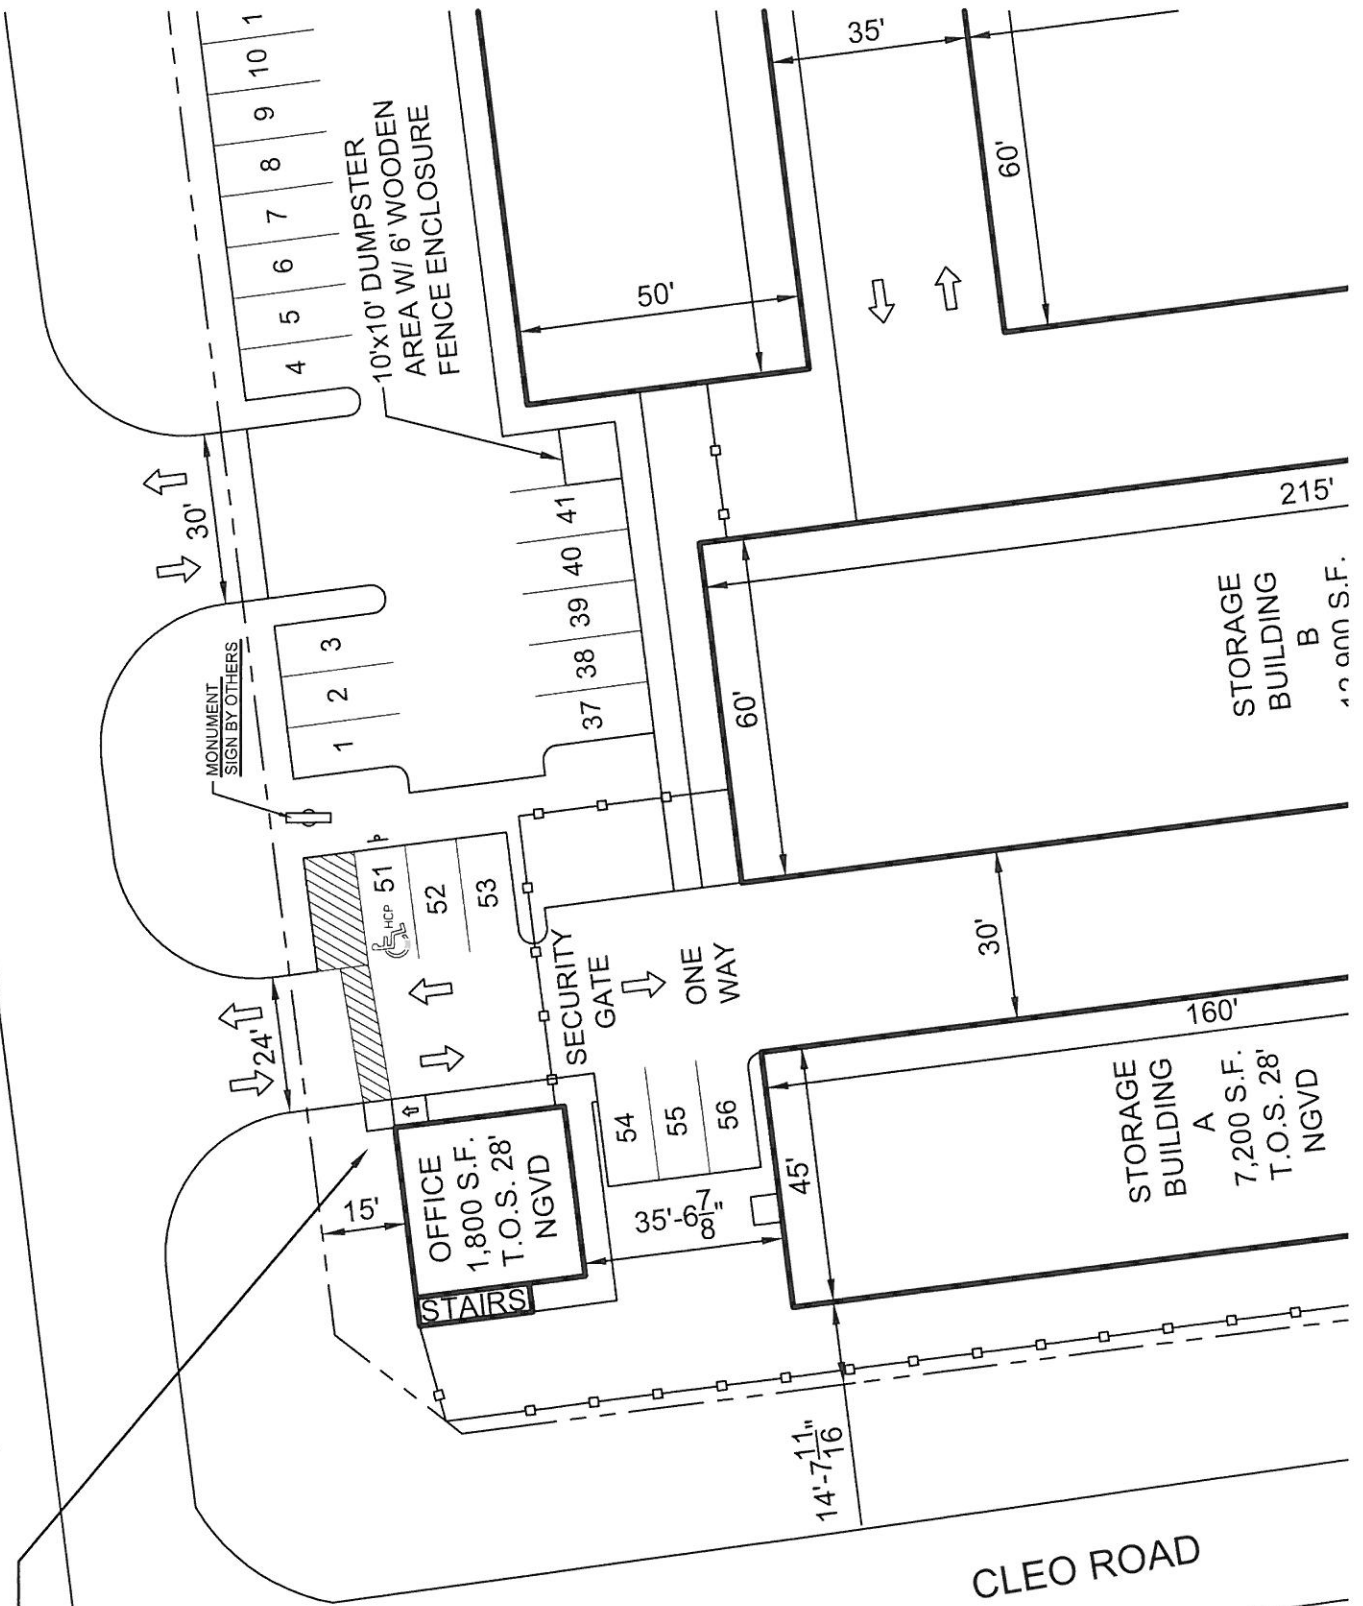

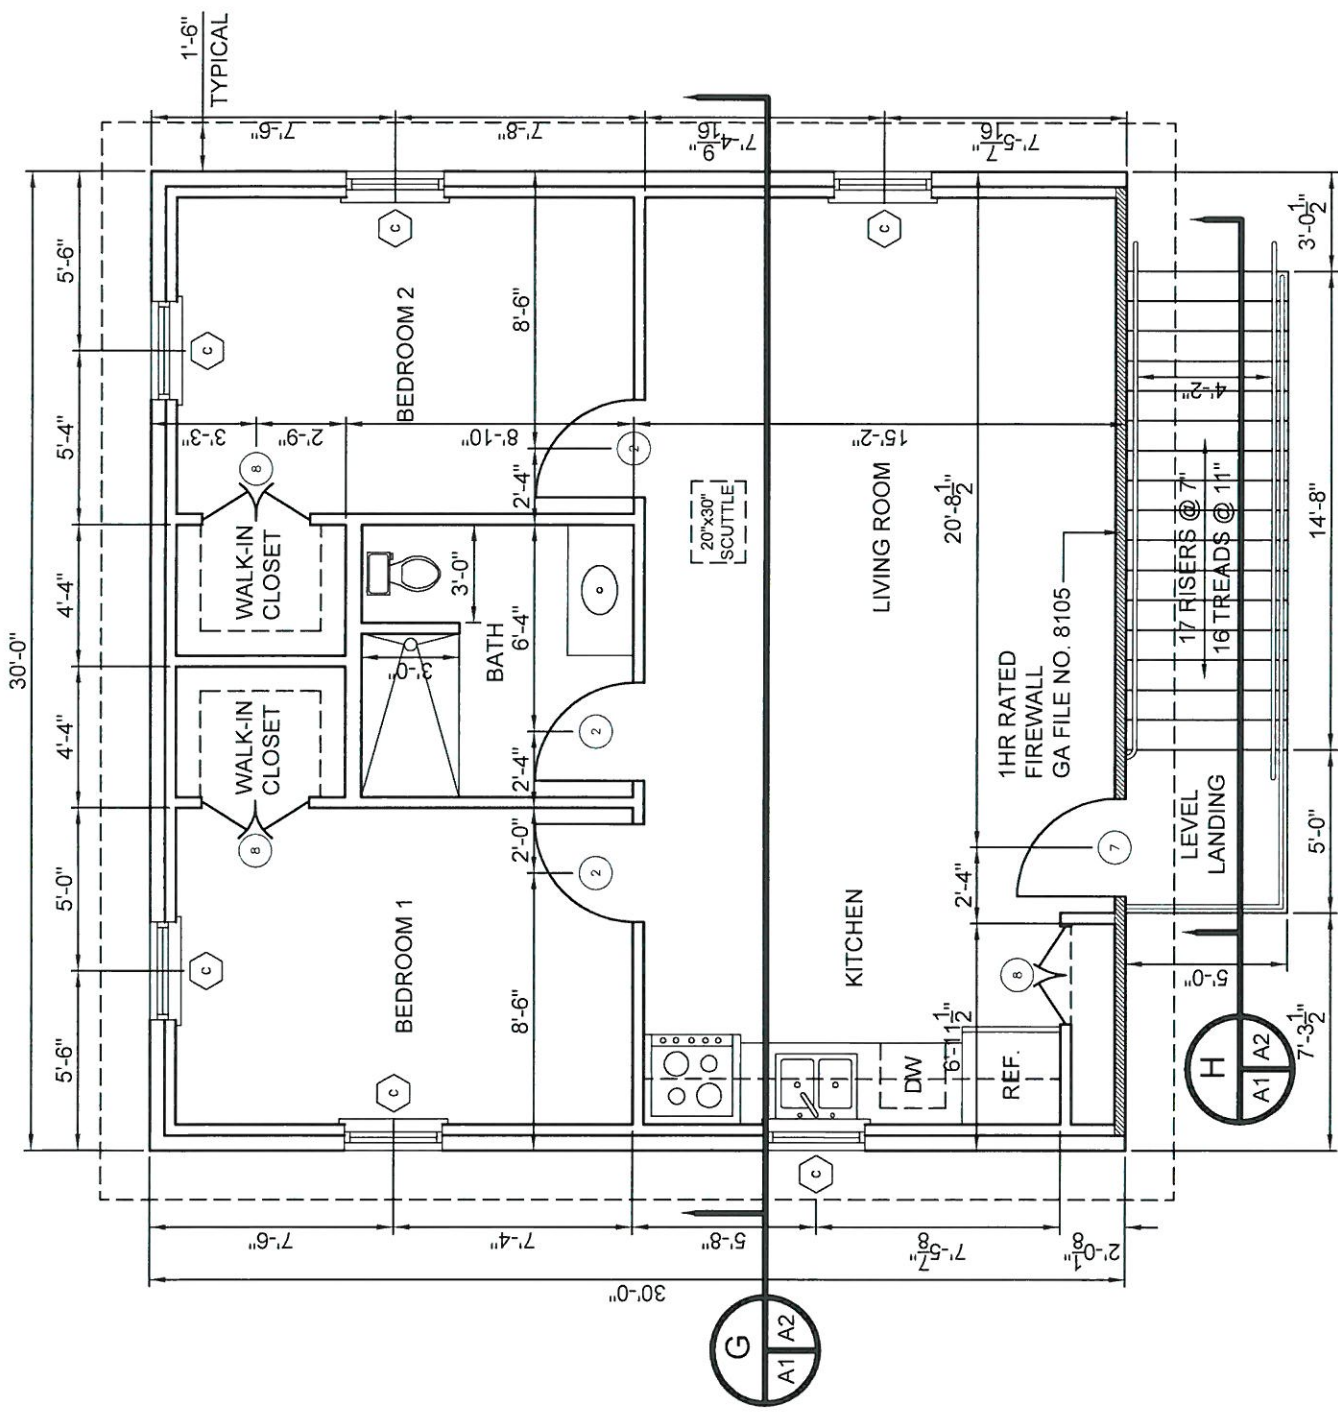

OFFICE SECOND FLOOR PLAN

SCALE: 1/2"=1'-0"