

Dammon Engineering Inc.

1095 Florida Ave.
Slidell, LA 70458
(985) 649-5832
Fax: (985) 641-5950

FAX COVER SHEET

FAX NUMBER TRANSMITTED TO: 781-9819

TO: Brian Piene

FROM: Brandon

CLIENT/MATTER: Pearl River Storage

REFERENCE: _____

DATE: 10-27-06 NO. OF PAGES INCLUDING COVER SHEET: 2


COMMENTS: _____

Preliminary Site Plan. Let me know what you think.

IF YOU EXPERIENCE ANY PROBLEMS RECEIVING THIS FAX, PLEASE CALL (985) 649-5832,
OR FAX (985) 641-5950

1,800 SF office (2 story)
 102,210 SF Storage combined
 8,000 SF RV/BOAT - (14) 35x15 Slips.

Storage @ 7-5

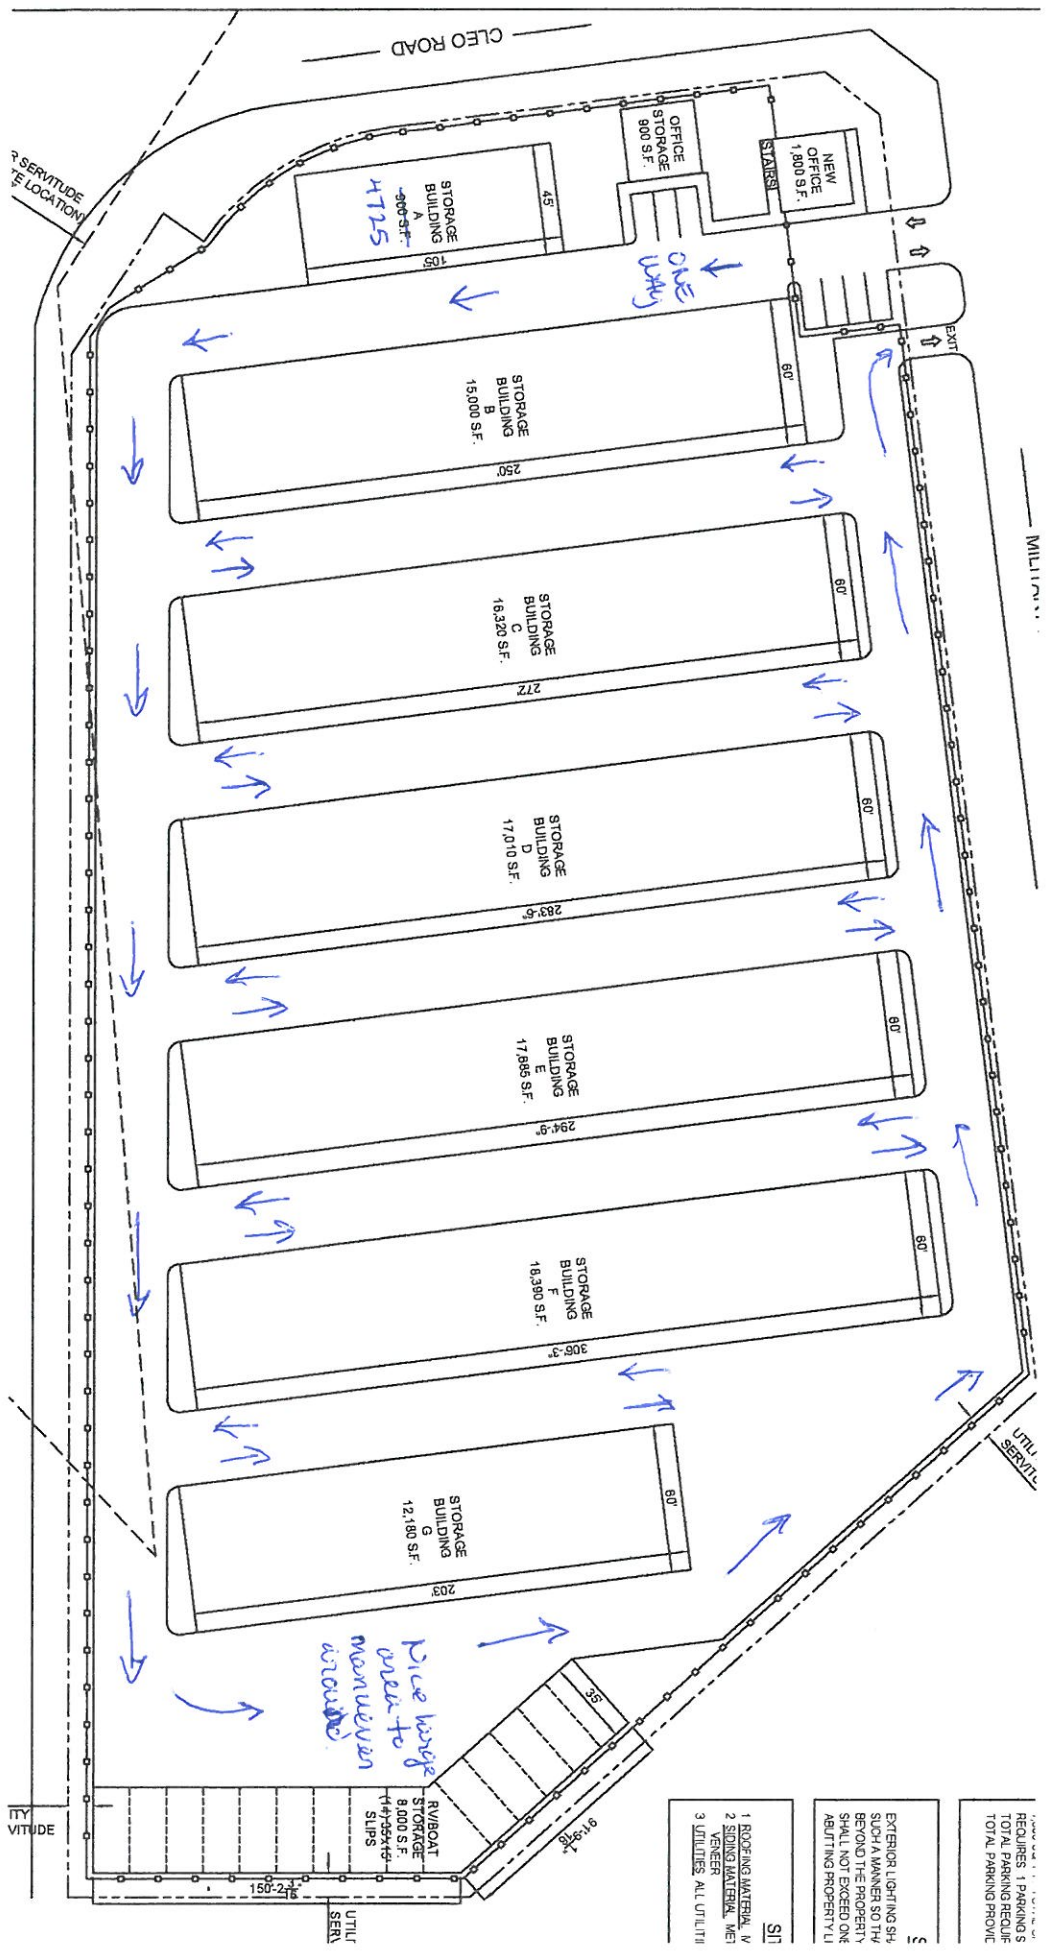

- REQUIRES: 1 PARKING S TOTAL PARKING REQUIRE TOTAL PARKING PROVIDE
- EXTERIOR LIGHTING SH- SUCH A MANNER SO TH- BEYOND THE PROPERTY SHALL NOT EXCEED ONE ABUTTING PROPERTY LI
- SI) 1 ROOFING MATERIAL, V VENERE 2 SIDING MATERIAL, MET 3 UTILITIES, ALL UTILIT

CALL ME