


A/C = Mrs. ~~Hand~~ C and Davis
 N/C = new climate controlled

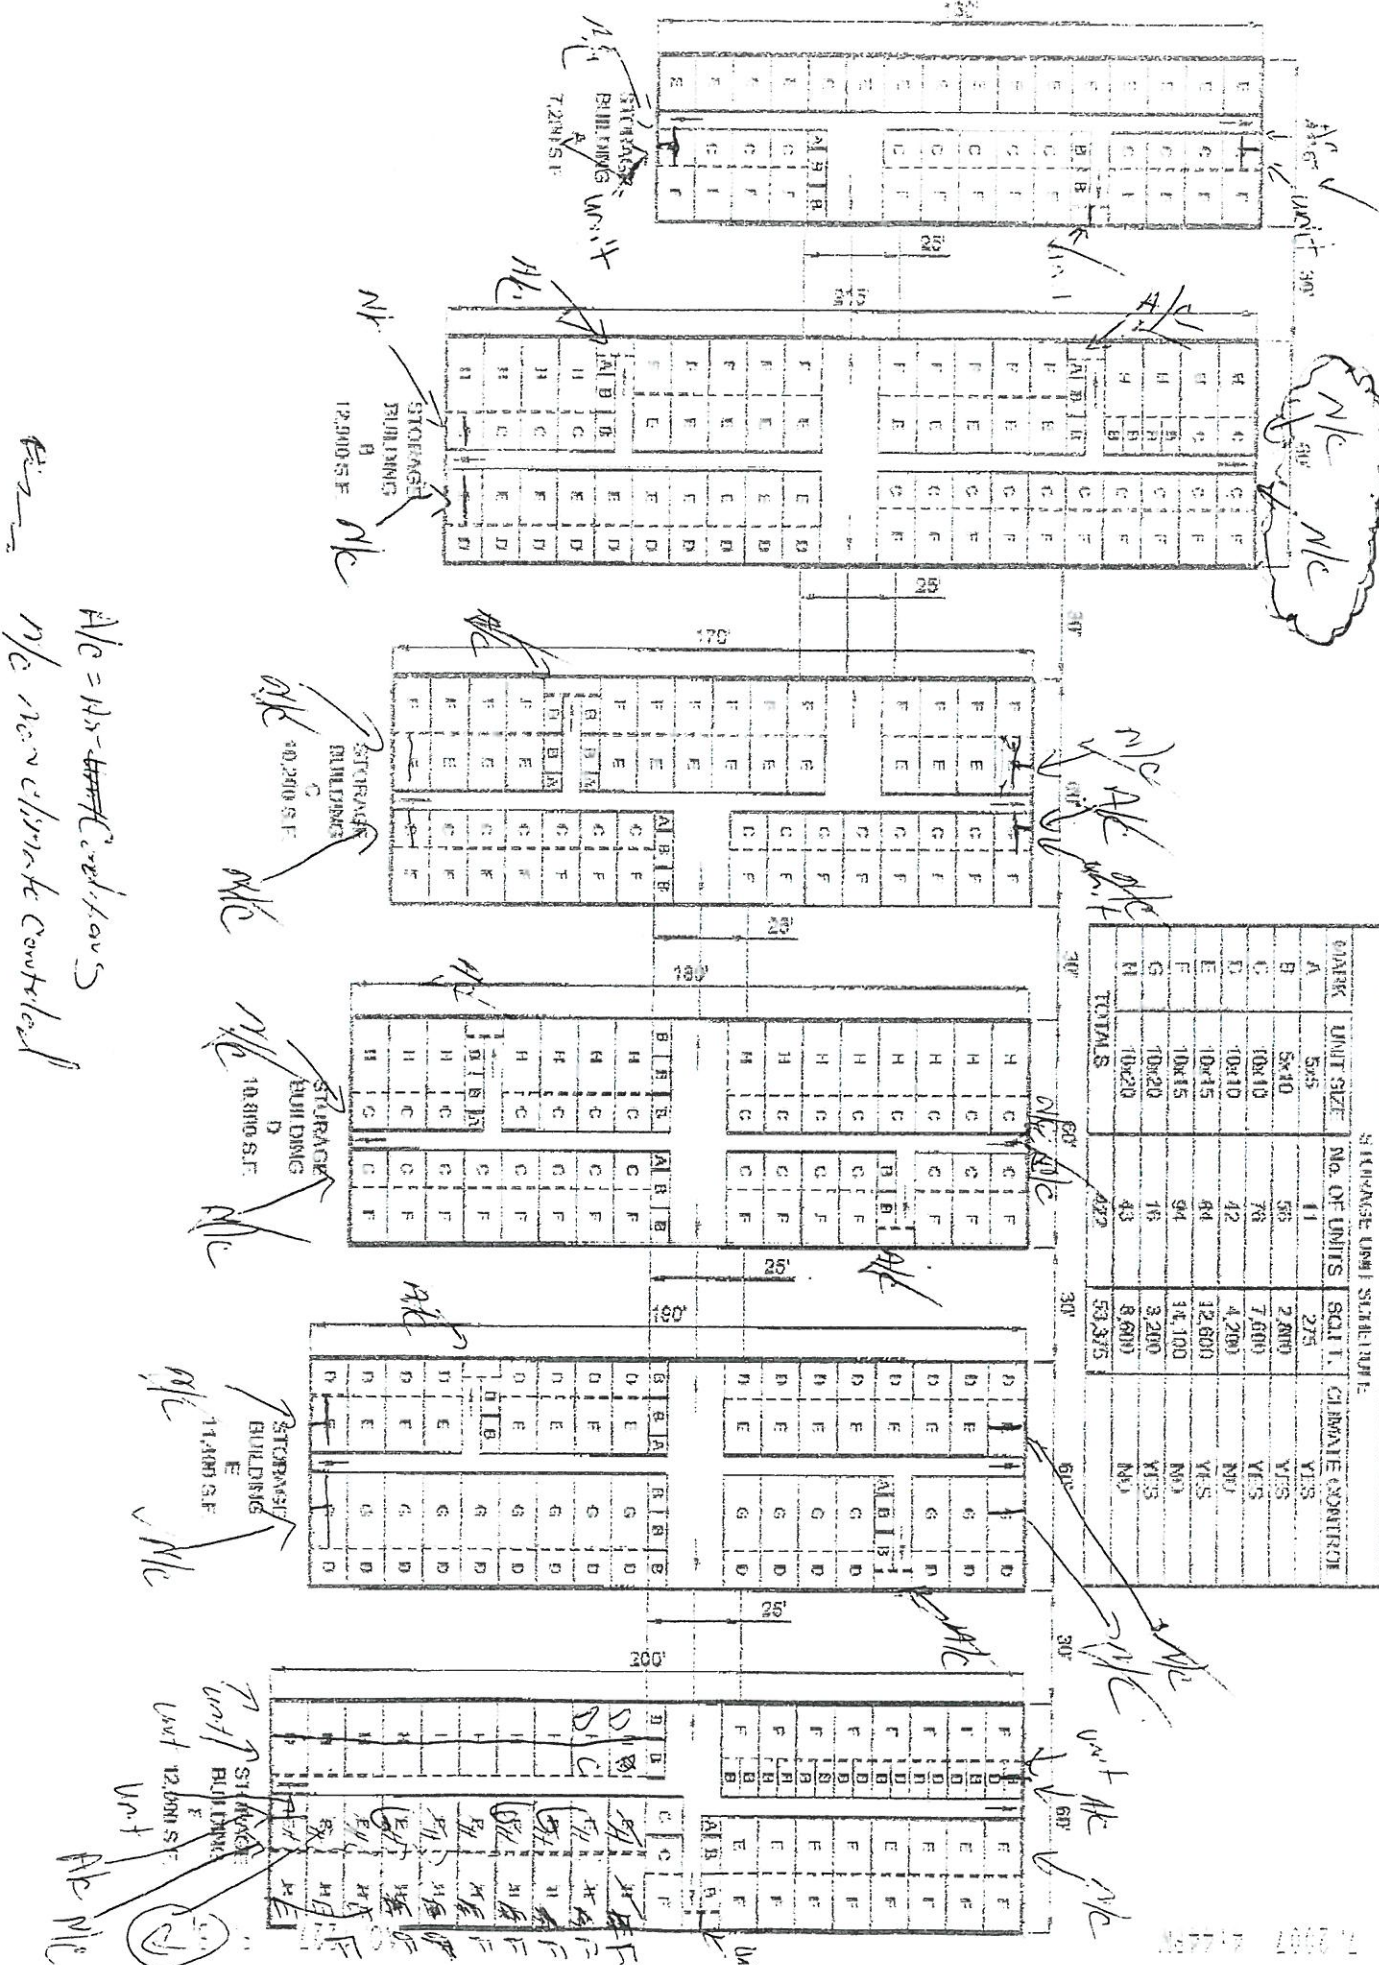


A	5x5	11	275	YES
D	10x10	42	4,200	NO
F	10x15	94	14,100	NO
H	10x20	43	8,600	NO

SCOTT
 201.0735