




MK	SIZE	TYPE	DOOR MATERIAL	FRAME MATERIAL	FRAME TYPE	FR	REMARKS
A101A	2'-3'-0"x7'-0"	C	ALUM/GLASS	ALUM	F1	NR	ALUM STOREFRONT SYSTEM
A103A	2'-3'-0"x7'-0"	C	ALUM/GLASS	ALUM	F1	NR	ALUM STOREFRONT SYSTEM
A104A	3'-0"x7'-0"	B	ALUM/GLASS	ALUM	F3	NR	ALUM STOREFRONT SYSTEM
A104B	3'-0"x7'-0"	B	ALUM/GLASS	ALUM	F3	NR	ALUM STOREFRONT SYSTEM
A105A	3'-0"x7'-0"	B	ALUM/GLASS	ALUM	F3	NR	ALUM STOREFRONT SYSTEM
A105B	3'-0"x7'-0"	B	ALUM/GLASS	ALUM	F2	NR	ALUM STOREFRONT SYSTEM
A106A	3'-0"x7'-0"	B	ALUM/GLASS	ALUM	F3	NR	ALUM STOREFRONT SYSTEM
A106B	3'-0"x7'-0"	B	ALUM/GLASS	ALUM	F2	NR	ALUM STOREFRONT SYSTEM
A107A	A107A	B	ALUM/GLASS	ALUM	F3	NR	ALUM STOREFRONT SYSTEM
A107B	A107B	B	ALUM/GLASS	ALUM	F2	NR	ALUM STOREFRONT SYSTEM
A108A	3'-0"x7'-0"	A	SC WOOD	HOLLOW METAL	F4	NR	
A109A	3'-0"x7'-0"	A	SC WOOD	HOLLOW METAL	F4	NR	
A110A	3'-0"x7'-0"	A	SC WOOD	HOLLOW METAL	F4	NR	
A111A	3'-0"x7'-0"	A	SC WOOD	HOLLOW METAL	F4	NR	
A112A	2'-0"x7'-0"	D	INSULATED METAL	HOLLOW METAL	F4	NR	GALV METAL SECURITY DOOR

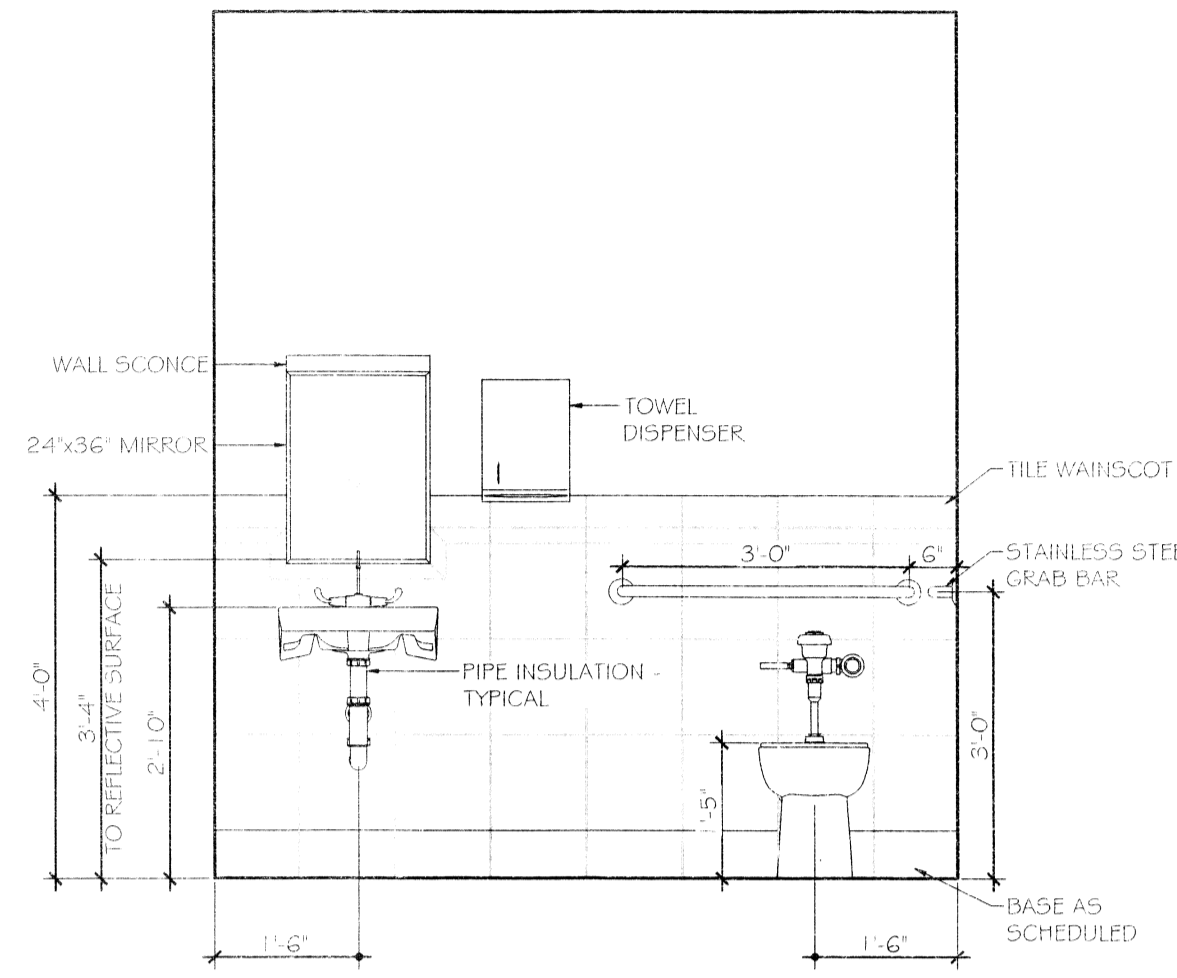


5 INTERIOR ELEVATION - TYPICAL RESTROOM
SCALE: 1/2" = 1'-0"

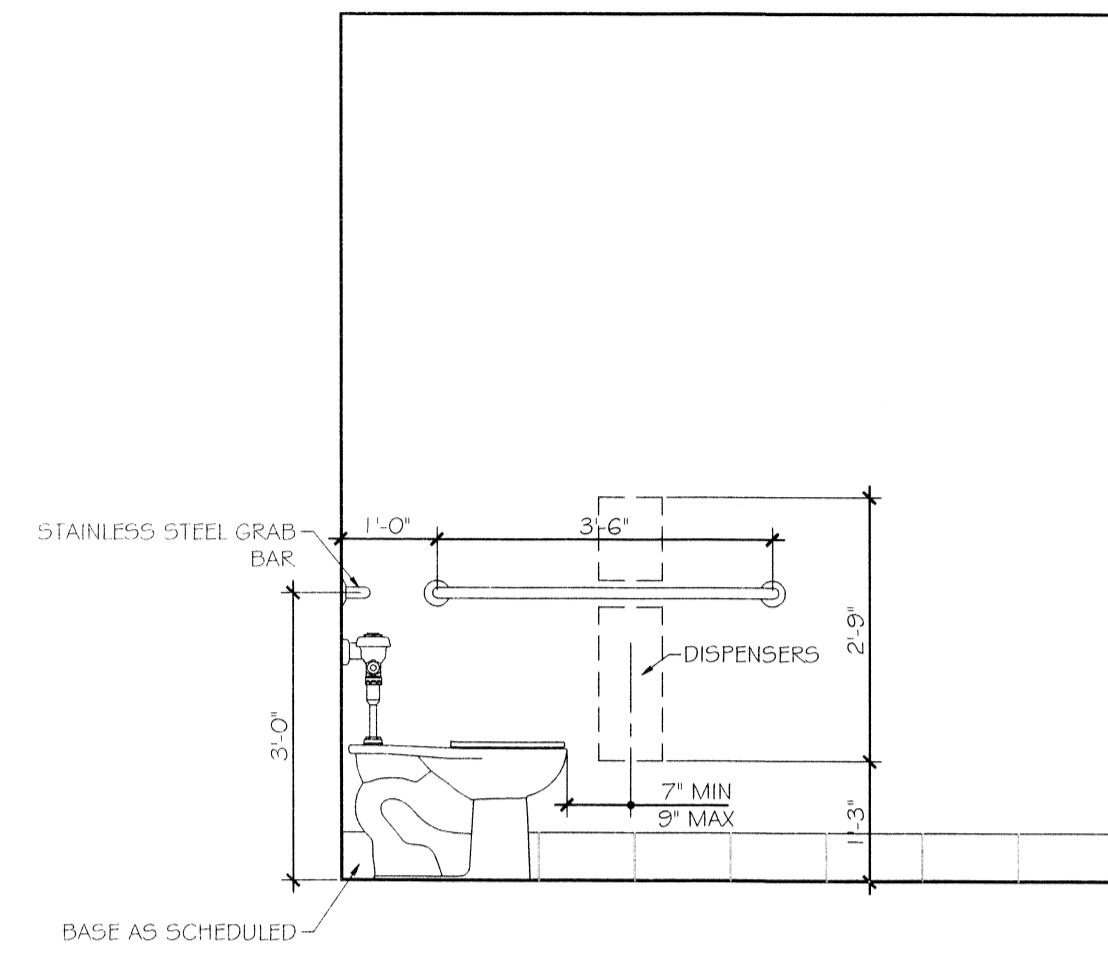


4 INTERIOR ELEVATION - TYPICAL RESTROOM
SCALE: 1/2" = 1'-0"

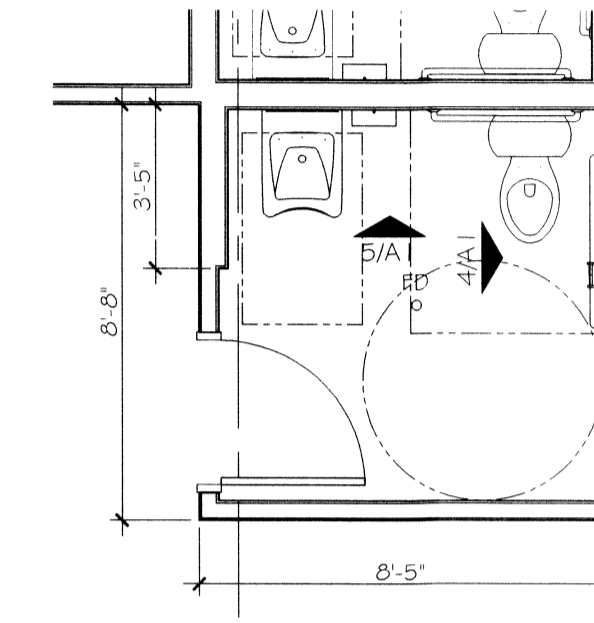

3 ENLARGED FLOOR PLAN - TYPICAL RESTROOM
SCALE: 1/4" = 1'-0"

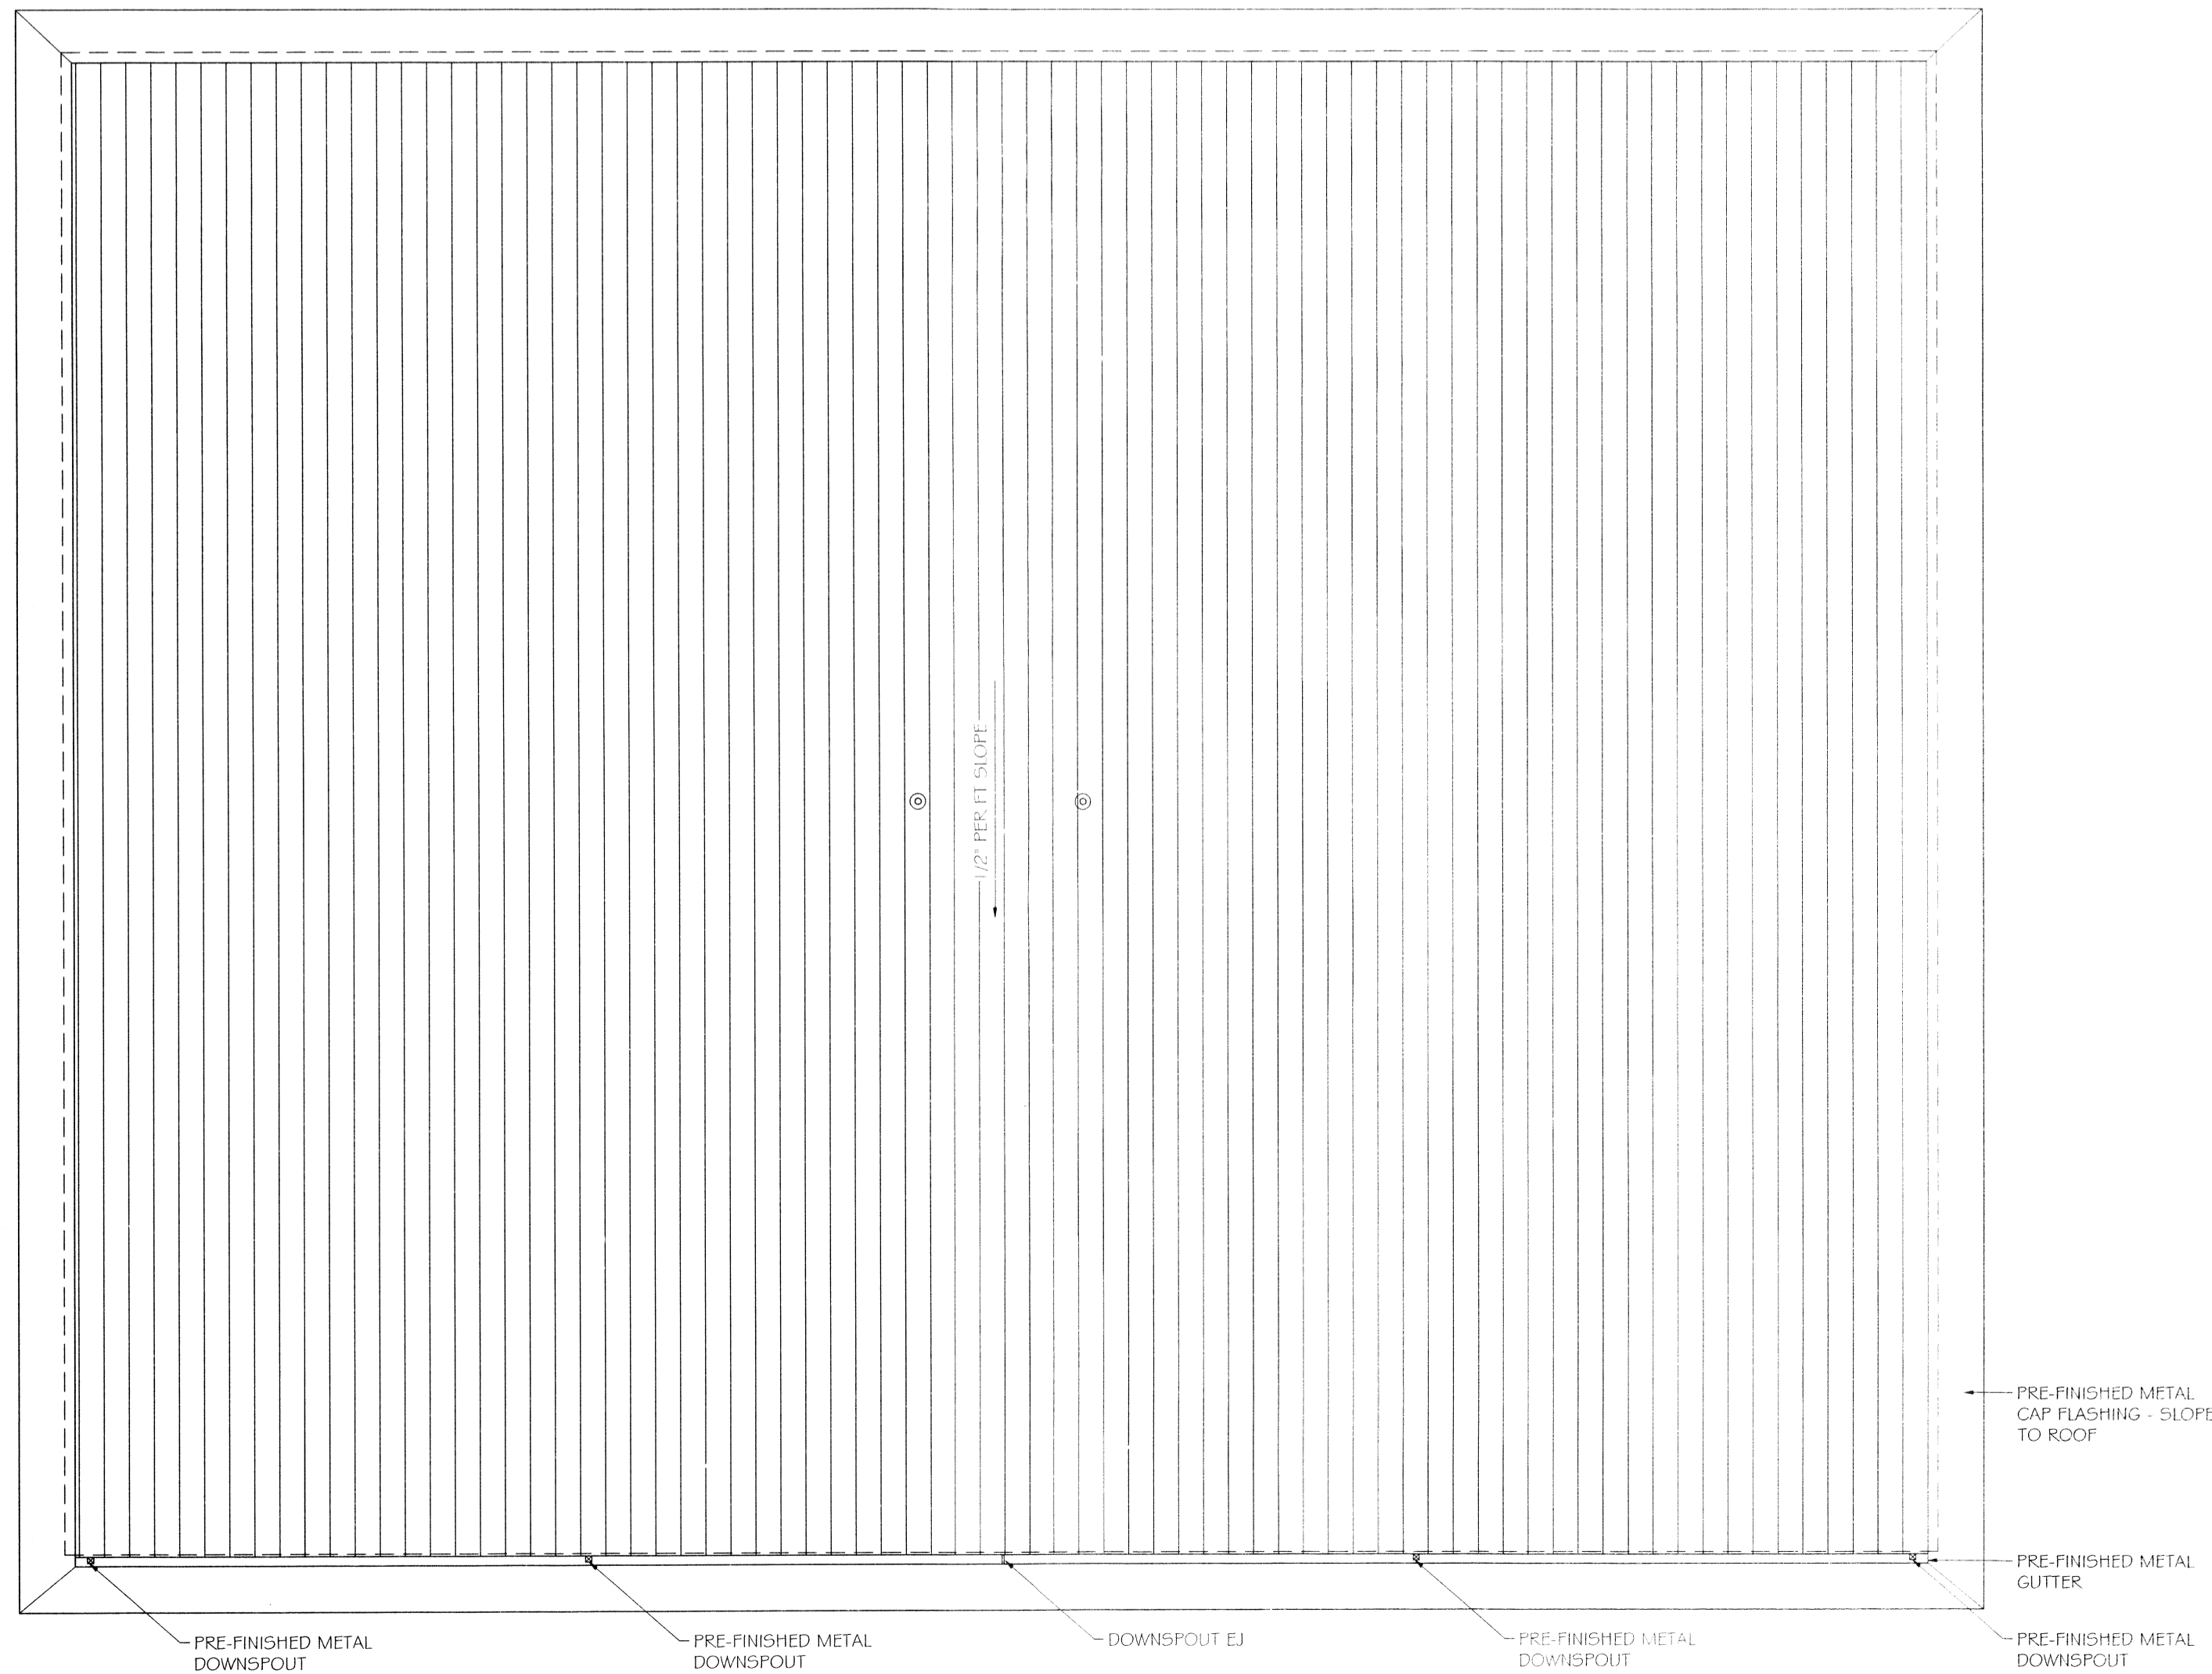

2 ROOF PLAN
SCALE: 1/4" = 1'-0"

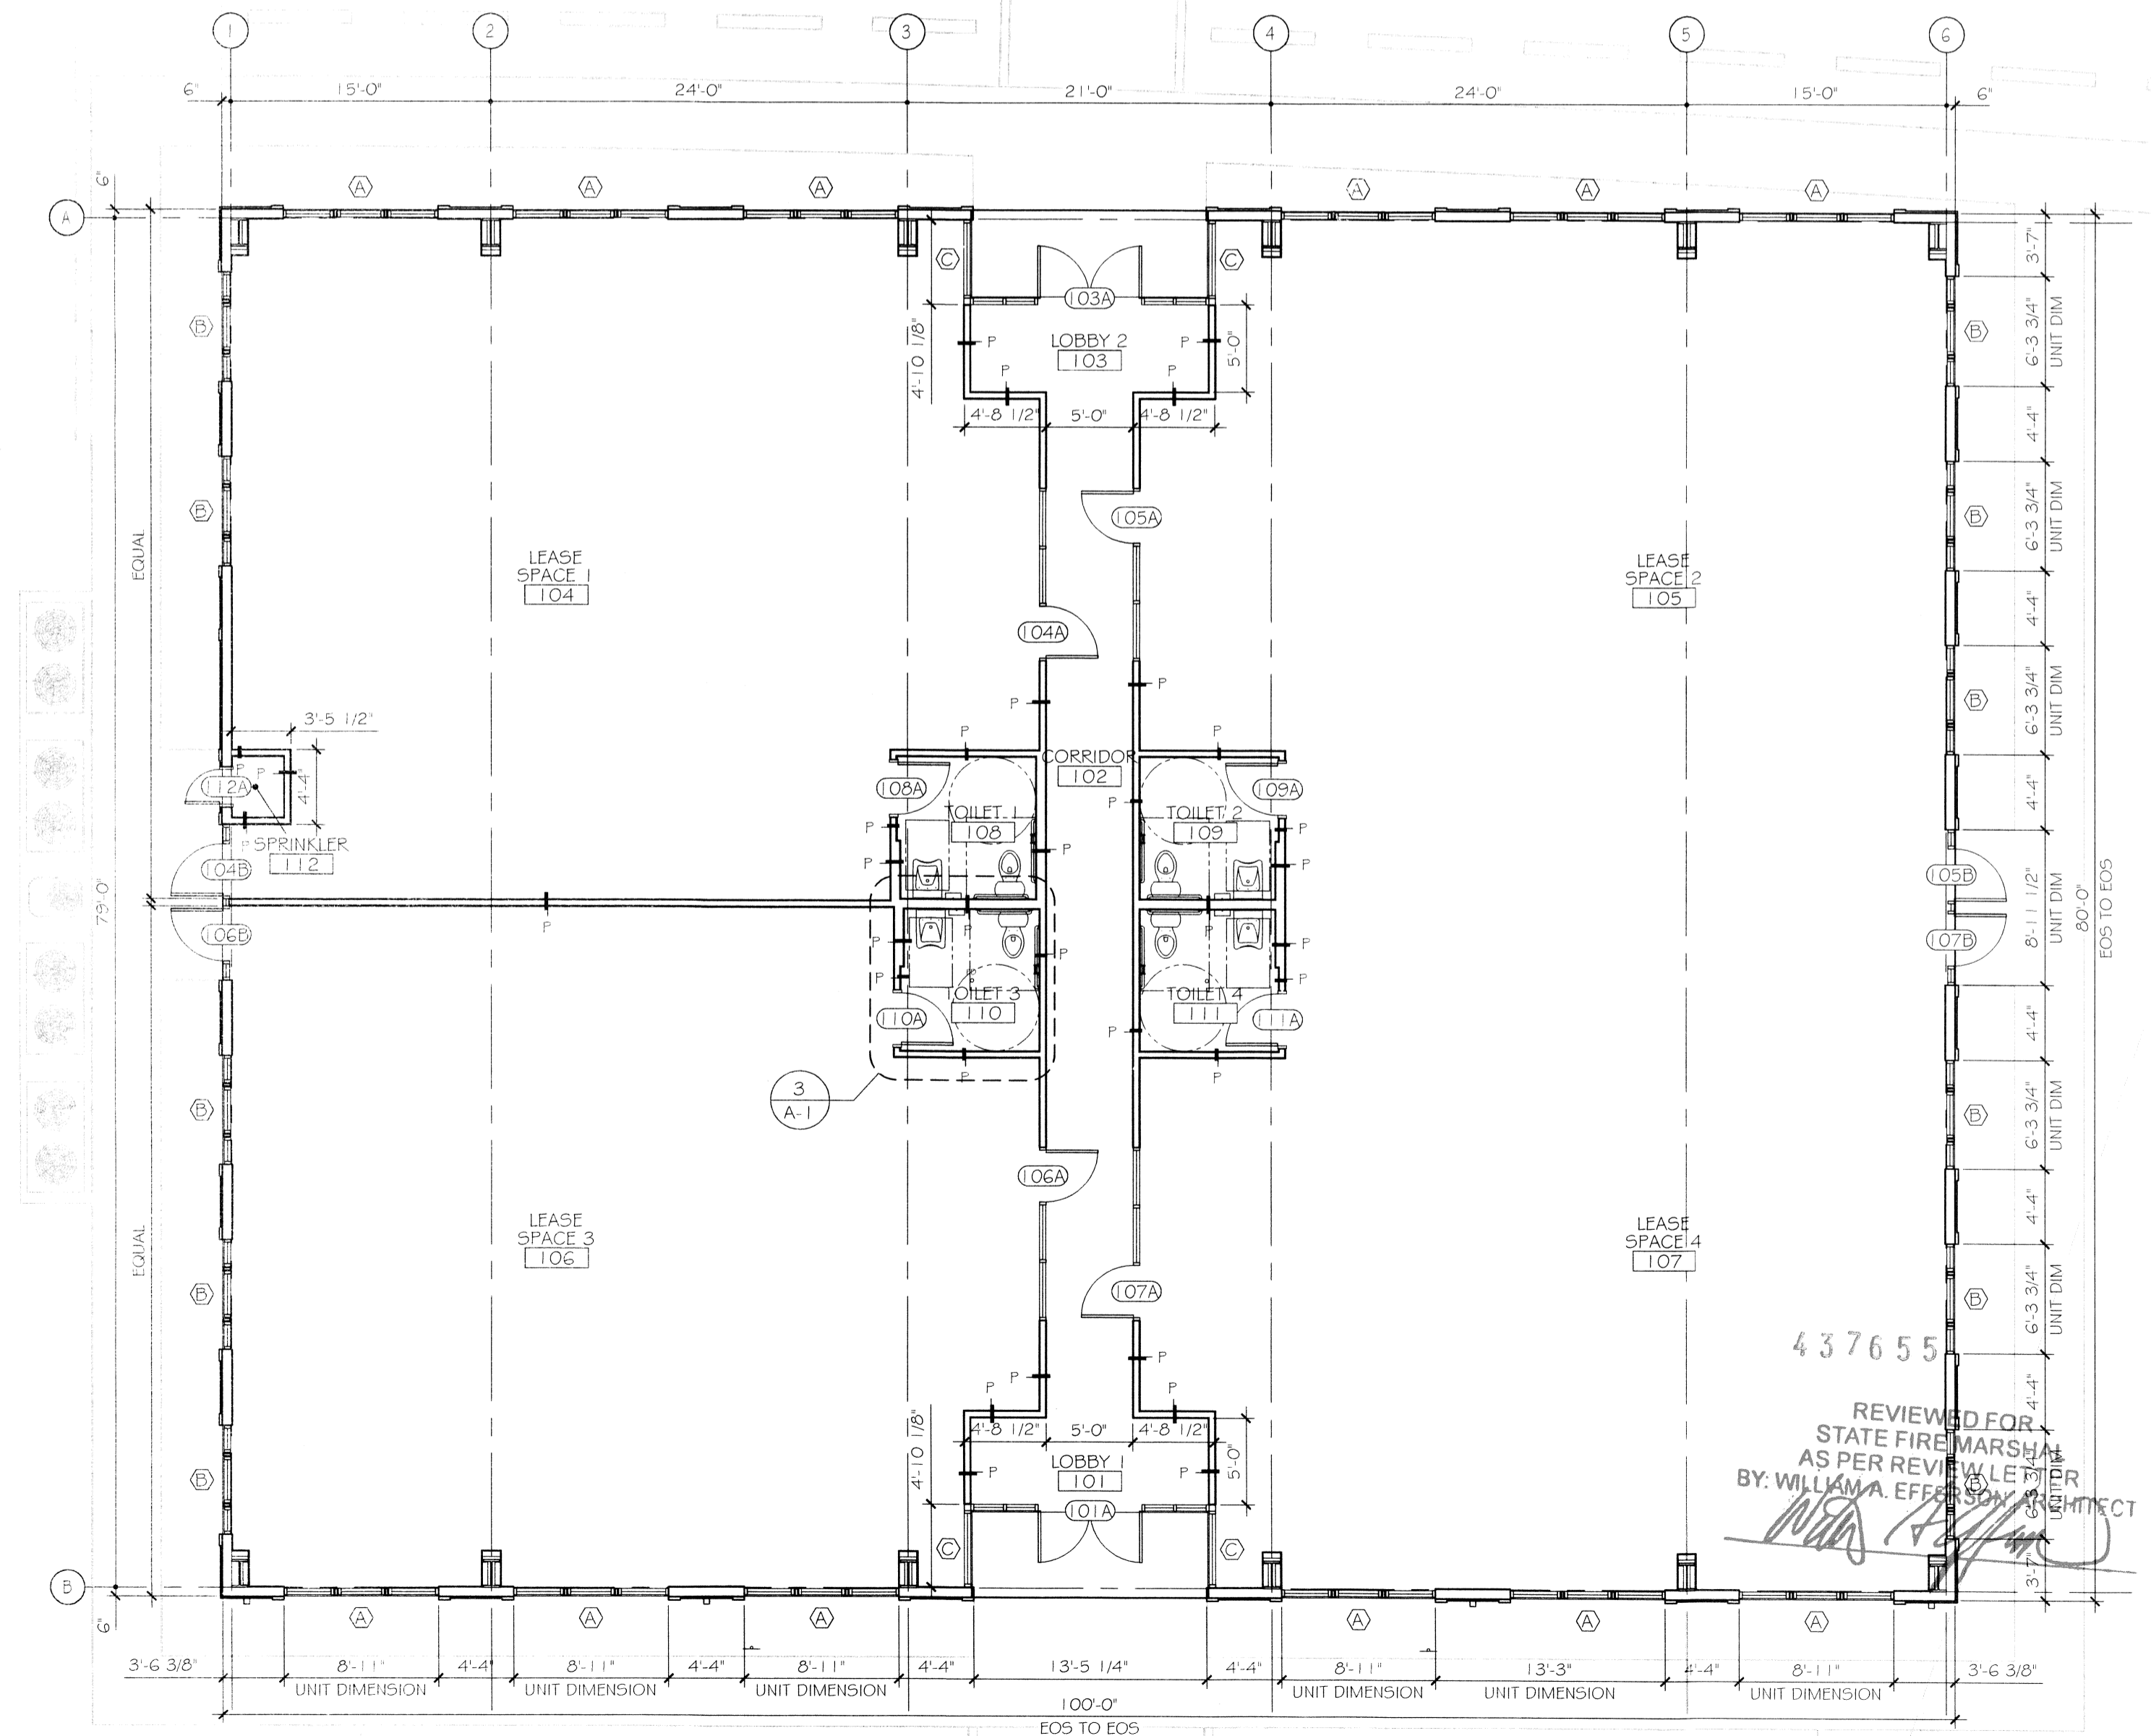

FLOOR PLAN
SCALE: 1/4" = 1'-0"

#	DESCRIPTION	REVISIONS	DATE

437655
REVIEWED FOR STATE FIRE MARSHAL AS PER REVISED LETTER BY WILLIAM A. EFFERSON REGISTERED ARCHITECT