

NEW COMMERCIAL BUILDING DR. FARZAD ADULI

LOT 288, MARIGOLD DRIVE, COVINGTON, LA



437655


REVIEWED FOR
STATE FIRE MARSHAL
AS PER REVIEW LETTER
BY: WILLIAM A. ETHERSON ARCHITECT

William A. Etherson

NEW COMMERCIAL BUILDING
DR. FARZAD ADULI
LOT 288 MARIGOLD DRIVE
COVINGTON, LA

JOB No: 2178 DATE: 08-16-2013
DRAWN BY: KJK CHECKED BY: KJK


#	DESCRIPTION	DATE

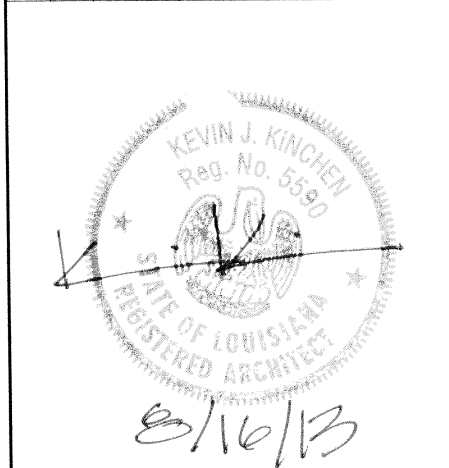

COVER SHEET

SHEET No: 1 of 8

COVER

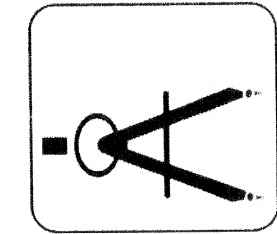

DAMMON
ENGINEERING, INC.
Architects & Engineers

dammoneng.com
dammoneng@bellsouth.net
PHONE: 985-649-5832
FAX: 985-641-5950
CHIEF ENGINEER: EMMETT DAMMON, P.E.
CHIEF ARCHITECT: KEVIN J. KINCHEM, LICARB
5010 SPANISH TRAIL
SUITE 100
SUDBELL, LA 70458