


OAK STREET

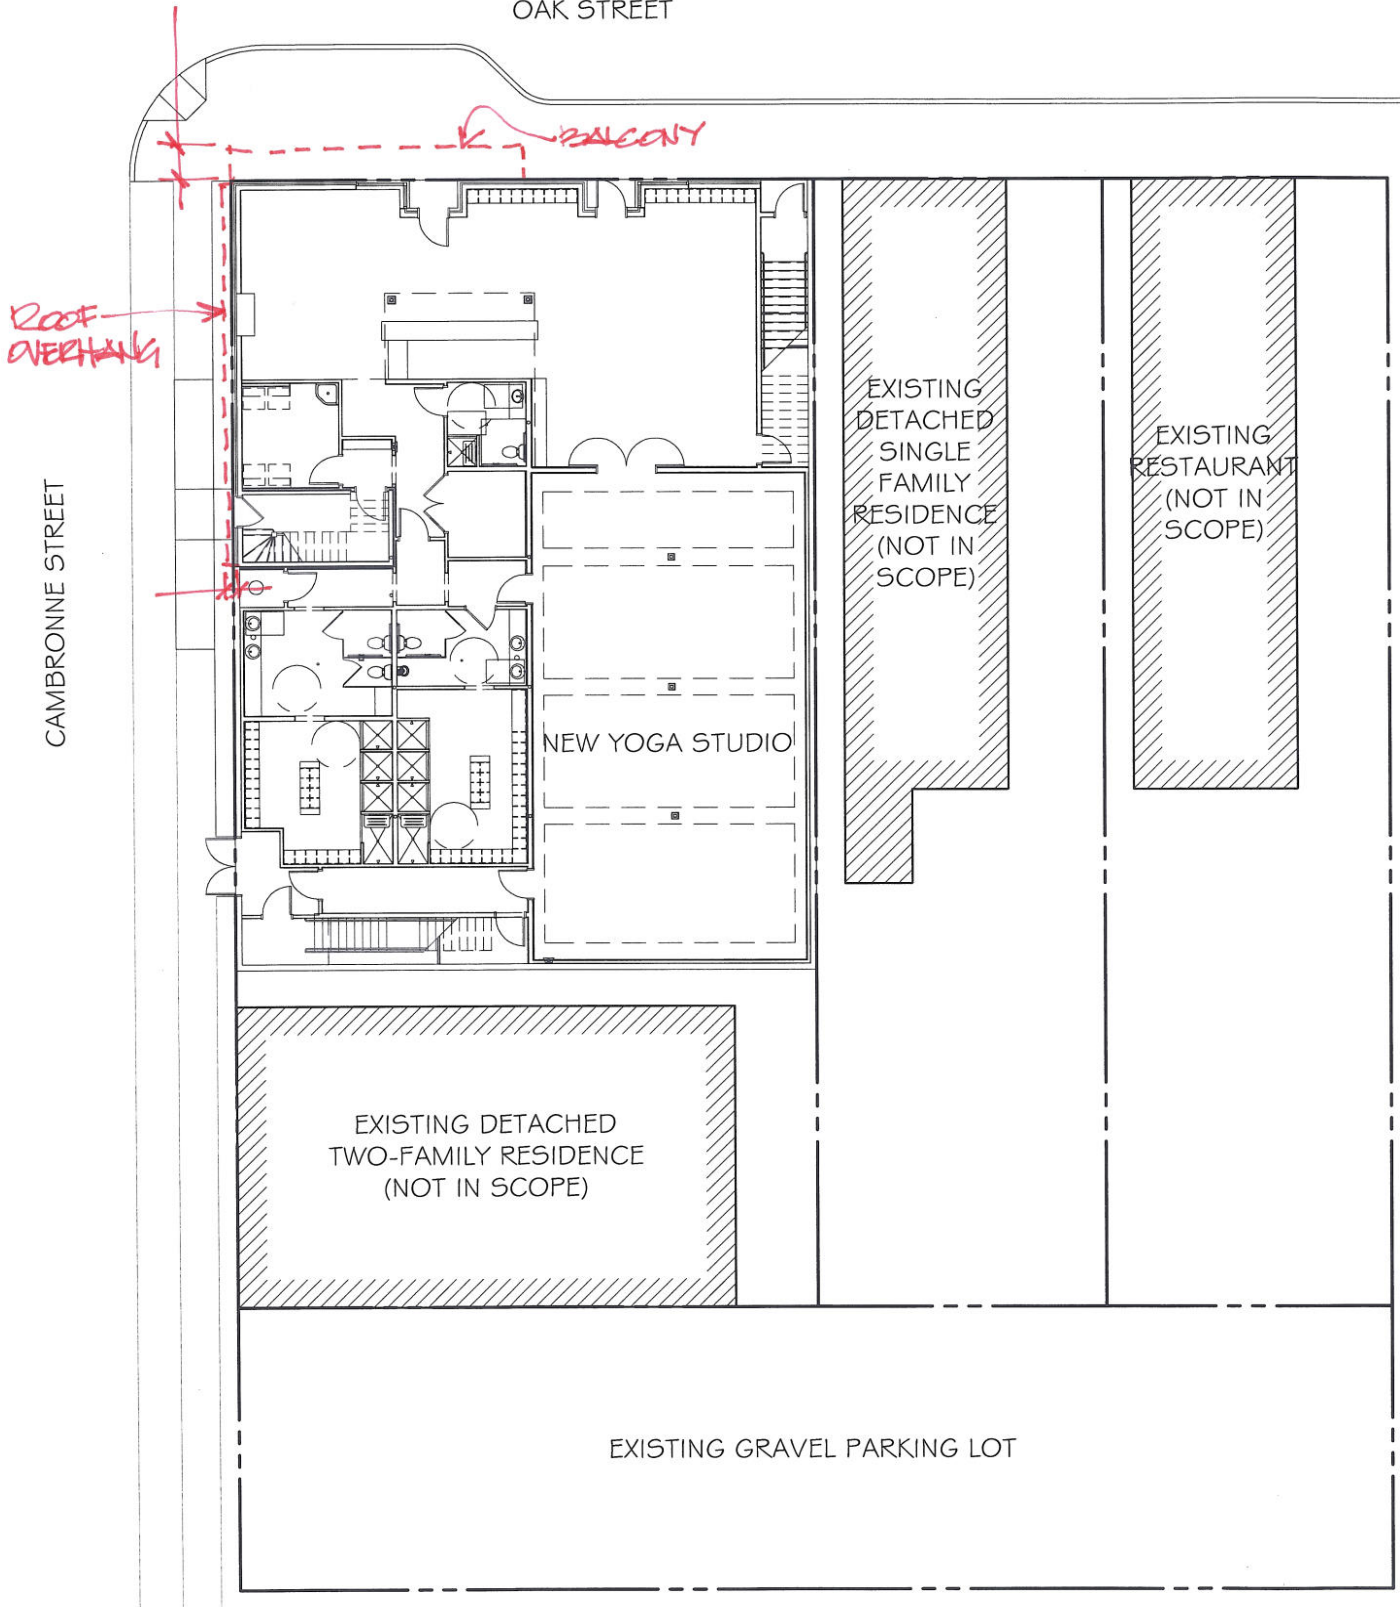

| SITE PLAN  
SCALE: 1" = 20'