



*3" CLEARANCE REDUCTION SYSTEM CONSISTING OF EITHER 22 GA SHEET METAL (SS) W/ 1" MINERAL WOOL BATTS OR CERAMIC FIBER BLANKET REINFORCED W/ WIRE MESH SPACED 1" ON NON-COMBUSTIBLE SPACERS PER NFPA 96:4.2.3.2.

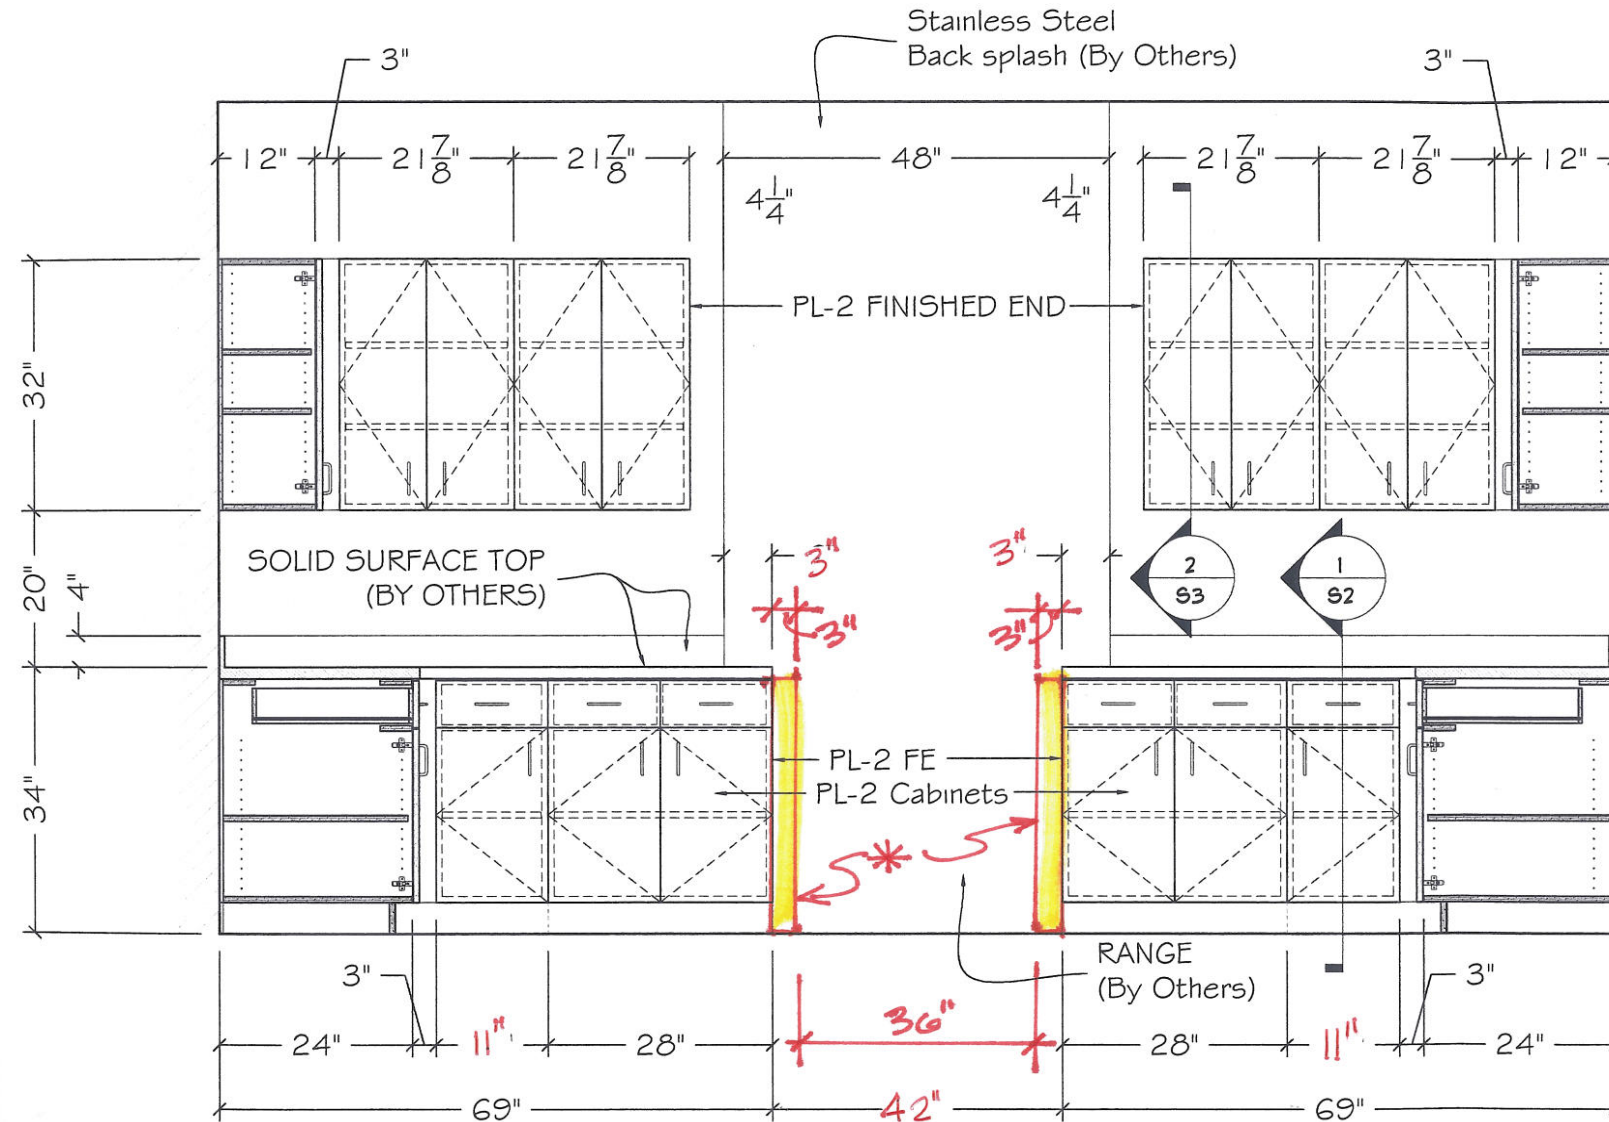

1 Elevation @ KITCHEN 117
2.4 SCALE: 1/2" = 1'-0"
ARCHITECTURAL REFERENCE: 3/A11

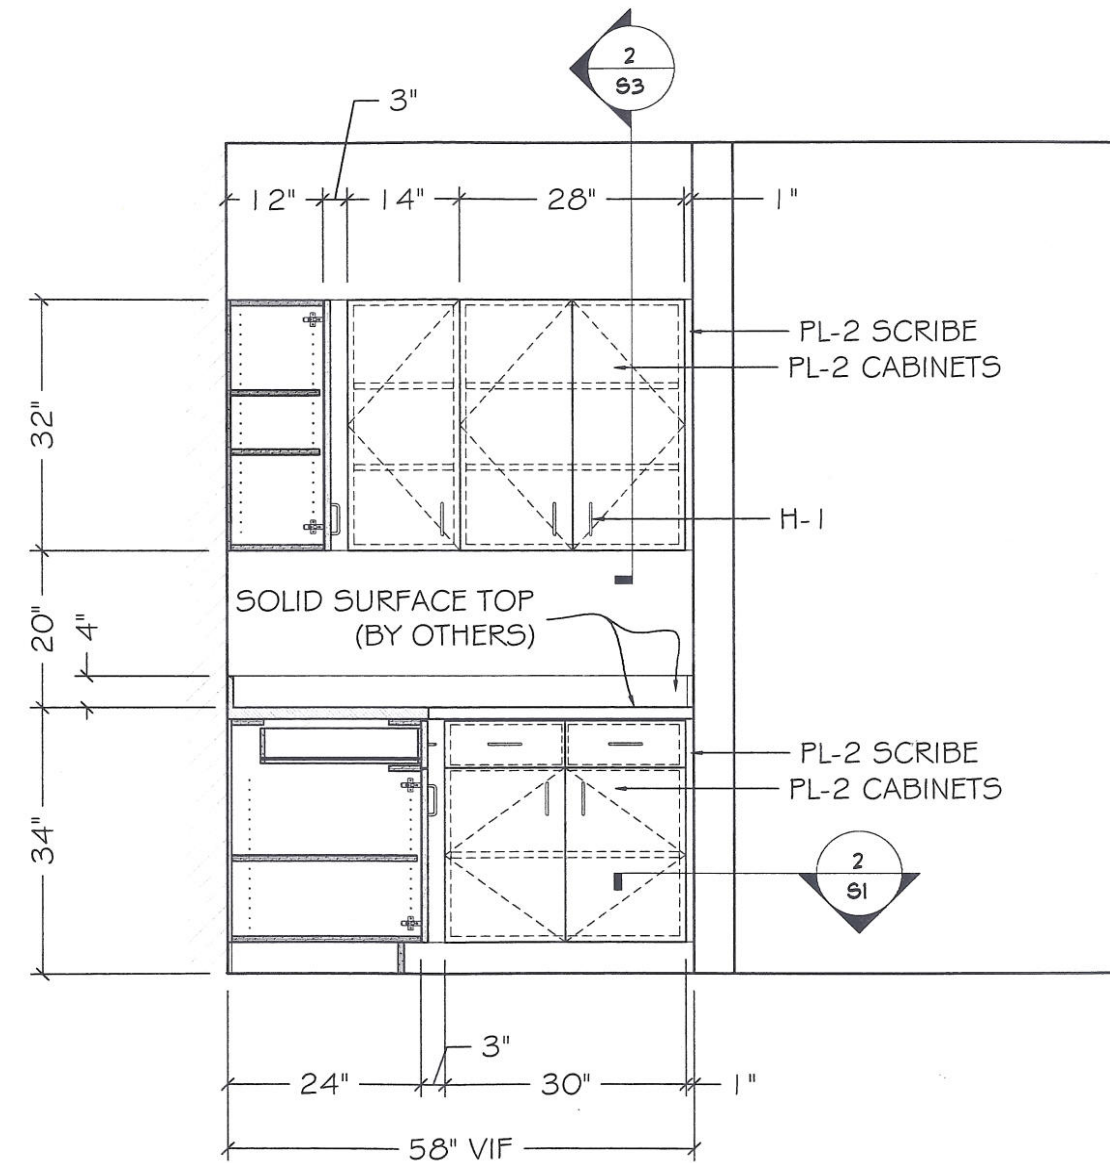

2 Elevation @ KITCHEN 117
2.4 SCALE: 1/2" = 1'-0"
ARCHITECTURAL REFERENCE: 4/A11