



*3" CLEARANCE REDUCTION SYSTEM CONSISTING OF EITHER 2.2 GA SHEET METAL (SS) W/ 1" MINERAL WOOL BATT'S OR CERAMIC FIBER BLANKET REINFORCED W/ WIRE MESH SPACED 1" ON NONCOMBUSTIBLE SPACERS PER NFPA 96:4.2.3.2.

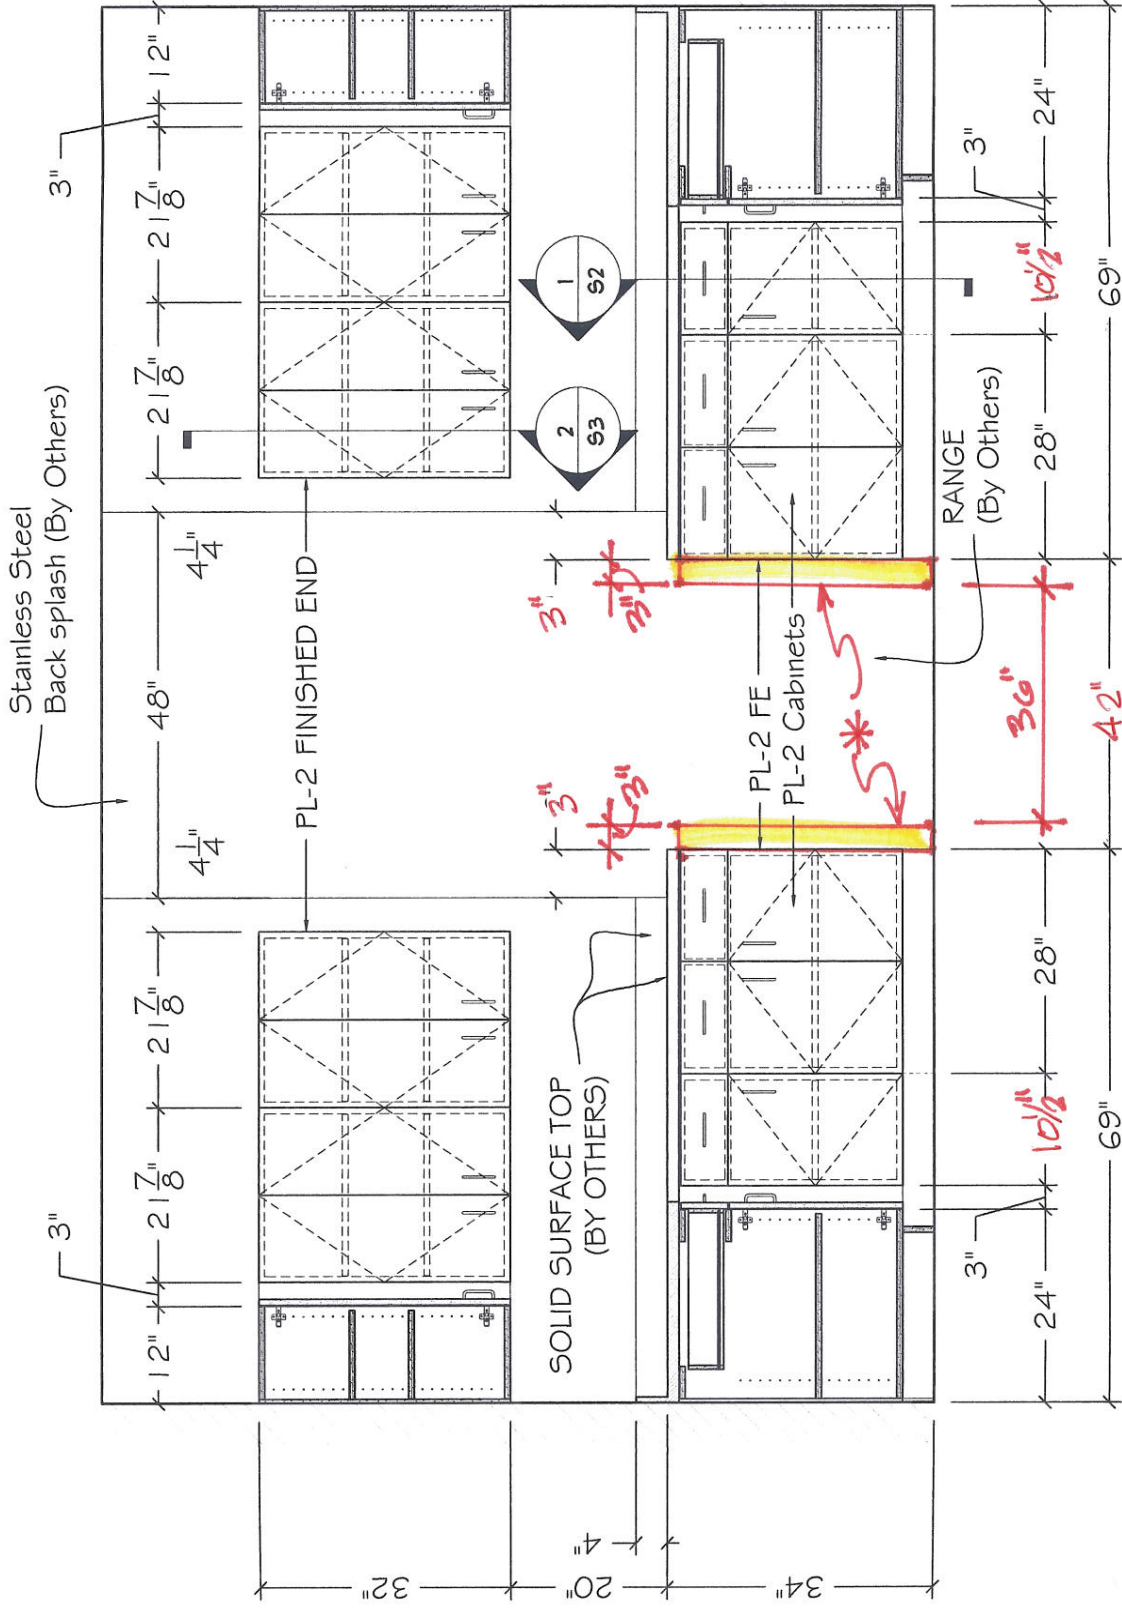

1 Elevation @ KITCHEN 117

2.4 SCALE: 1/2" = 1'-0"

ARCHITECTURAL REFERENCE: 3/A11

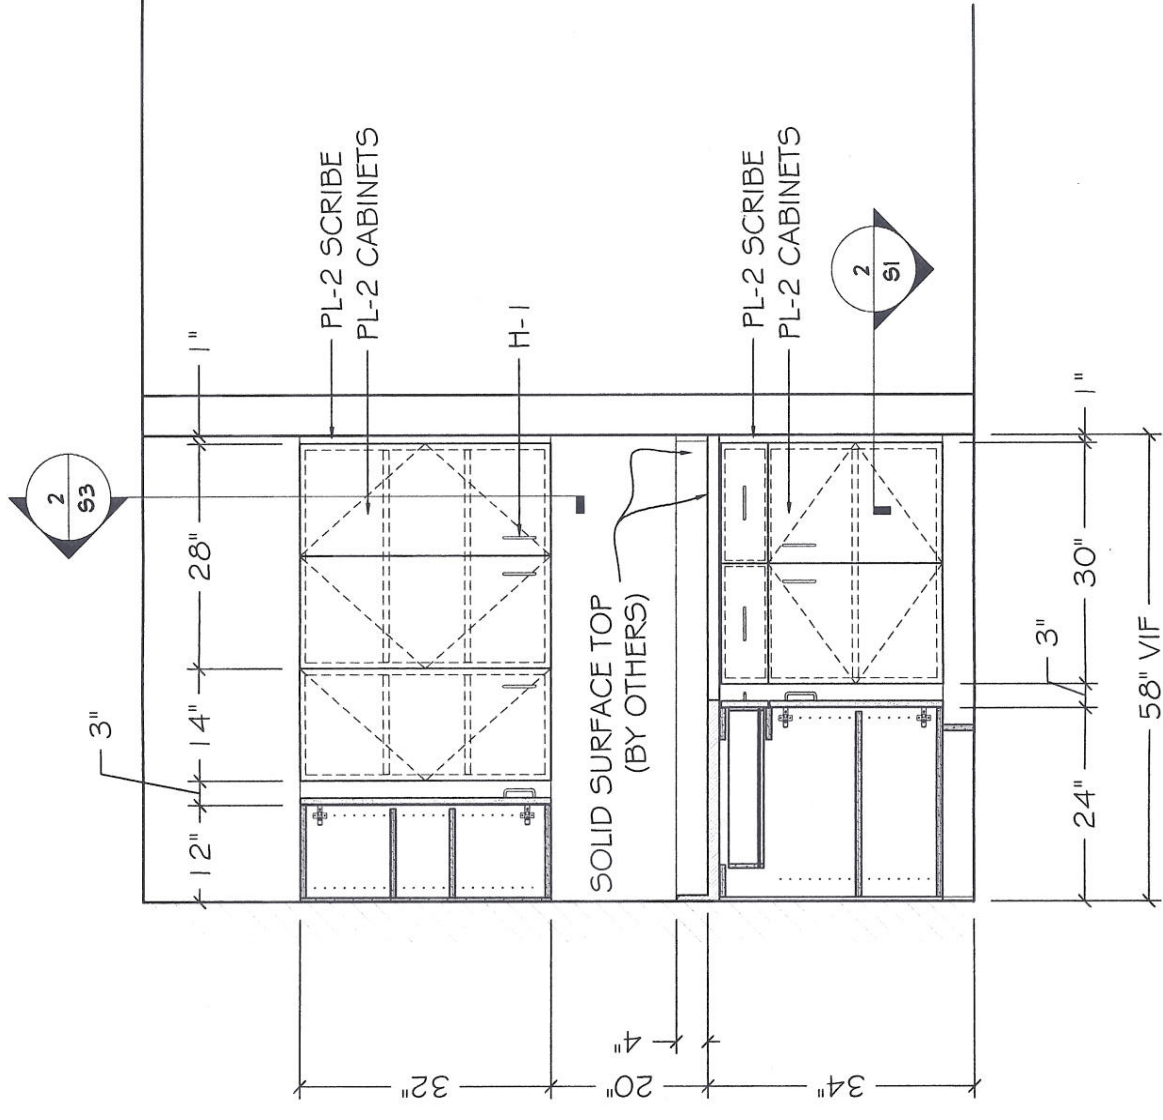

2 Elevation @ KITCHEN 117

2.4 SCALE: 1/2" = 1'-0"

ARCHITECTURAL REFERENCE: 4/A11

424 Saint Rose Avenue
 Saint Rose, LA 70087
 Office (504) 305-5504
 Fax (504) 305-5590

SONIAT CABINETS & MILLWORK

Approved By:

Project: FIRE STATION #14 - ST. TAMMANY FIRE PROTECTION DISTRICT NO.1

Item: KITCHEN 117

Revised:

Date Drawn: 10/24/2013

Job#

Drawing #

2.4