FINISH SCHEDULE				
ROOM #	NAME	FLOORS	WALLS	CEILING
1	RECPT.	VINYL	SH. ROCK	SH. ROCK
2	OFFICE	VINYL	SH. ROCK	SH. ROCK
3	CONFERENCE	VINYL	SH. ROCK	SH. ROCK
4	ADA BATH	VINYL	SH. ROCK	SH. ROCK
5	PILOTS LOUNGE	VINYL	SH. ROCK	SH. ROCK

KEY NOTES:

1. 2X6 WALL
2. 2-2X12 BEAM ABOVE
3. RAILINGS ARE TO HAVE 4" MIN.SPACE BETWEEN BALUSTERS, AND 34" TO 38"HIGH.
4. 7/11
5. 1½" DIAMETER SATIN FINISHED ALUMINUM GRAB BAR WITH KNURLED GRIP
6. ROLL TYPE PAPER TOWEL DISPENSER
7. TOILET TISSUE HOLDER
8. MIRROR
9. SOAP DISPENSER W/ LEVER TYPE HARDWARE
10. ADA APPROVED WALL HUNG LAVATORY
11. ADA APPROVED TOILET
12. FLOOR DRAIN TO OIL SEPERATOR
13. VERTICAL A/C SEE UNIT CLOSET. SEE MECHANICAL SHEET FOR SPECIFICATIONS
14. 2 HR. FIRE WALL SEE NOTES

GENERAL NOTES:

1. 4.5.2 THRESHOLDS SHALL COMPLY WITH REQUIREMENTS OF THIS SECTION REGARDING CHANGES IN LEVEL. (NOT MORE THAN ½" HGT. AND BEVELED IF OVER A ¼".
2. 4.13.9 DOOR HARDWARE SHALL COMPLY WITH THIS SECTION. HARDWARE SHALL NOT REQUIRE TIGHT GRASPING, TIGHT PINCHING, OR TWISTING OF THE WRIST TO OPERATE.
3. 101:7.2.1.3.1 AND 7.1.6.3 FLOOR ELEVATION SHOULD NOT CHANGE HEIGHT FROM ONE SIDE OF DOOR TO THE OTHER MORE THAN ½". PROVIDE LEVEL LANDINGS ON BOTH SIDES OF EXIT DOOR.
4. 101:7.2.1.3 PROVIDE LEVEL LANDINGS OUTSIDE EXTERIOR DOOR THAT ARE WITHIN ½" OF THE INTERIOR FLOOR FINIHED ELEVATION.
5. 101:7.2.1.5 LOCKS ON DOORS IN MEANS OF EGREES SHALL NOT REQUIRE THE USE OF A KEY, SPECIAL DEVICE OR SPECIAL KNOWLEDGE TO OPEN IN THE DIRECTION OF EGRESS.
6. HVAC SYSTEM SHALL BE CONSTRUCTED IN ACCORDANCE WITH 101:9.2.
7. COMPLIANCE WITH THE 2005 NFPA 70, NATIONAL ELECTRICAL CODE (NEC), IS MANDATED BY RS 40:1730.28A(7).
8. 101:8.2.2.3 FIRE COMPARTMENTS SHALL BE FORMED BY FIRE BARRIERS THAT ARE CONTINUOUS FROM FOUNDATION THROUGH ALL INTERVENING CONSTRUCTION TO THE ROOF DECK. FROM OUTSIDE WALL TO OUTSIDE WALL OR FROM FIRE BARRIER TO FIRE BARRIER, INCLUDING CONTINUITY THROUGH ALL CONCEALED SPACES, SUCH AS THOSE FOUND ABOVE A CEILING, INCLUDING INTERSTITIAL SPACES.
9. 101:8.3.5 PENETRATIONS THROUGH RATED CONSTRUCTION SHALL BE SEALED BY APPROVED FIRESTOP SYSTEMS OR DEVICES TESTED IN ACCORDANCE WITH ASTM E-814 OR ANSI/UL 1479 OR BY ASSEMBLIES OF FIRESTOPPING MATERIALS CAPABLE OF PREVENTING THE PASSAGE OF FLAMES AND HOT GASES WHEN TESTED AND RATED IN ACCORDANCE WITH NFPA 251. (THIS REQUIREMENT APPLIES FOR ELEVATOR CONTROLS ON SHAFT WALLS, ELECTRICAL OUTLETS, LIGHT SWITCHES, ETC.).

   A) NOTIFY THE DISTRICT OFFICE IDENTIFIED AT THE END OF THIS LETTER FOR INSPECTION OF ALL COMPLETED FIRE AND/OR SMOKE BARRIER WALLS BEFORE ANY CONSTRUCTION IS INSTALLED THAT WOULD CONCEAL SUCH CONSTRUCTION AND PREVENT A PROPER INSPECTION. ACCESS TO RANDOMLY SELECTED AREAS MAY BE REQUIRED BY THE INSPECTOR AT THE TIME OF FINAL INSPECTION IF THIS NOTIFICATION IS NOT GIVEN.

   B) PROVIDE DETAILED INSTRUCTIVE CUT SHEETS OF THE FIRE PENETRATION SEALING SYSTEM USED TO THE INSPECTOR AT TIME OF INSPECTION. RANDOM SELECTIVE SAMPLING BY THE CONTRACTOR WILL BE OBSERVED BY THE INSPECTOR.
10. LAC 55:V:303.D PROVIDE LISTED PORTABLE FIRE EXTINGISHERS IN ACCORDANCE WITH NFPA 10. (REFER TO APPENDIX E FOR DISTRIBUTION INFORMATION).

    A) NFPA 10.3.3.4 CLASSIFICATION FOR FIRES

LEGEND:

NON-RATED WALL: ½" GYP. BD. BOTH SIDES OF 2"x4" WOOD STUDS OR 1⅝"x3⅝" 22 GA. METAL STUDS AT 16" O.C.

NON-RATED WALL: ½" GYP. BD. BOTH SIDES OF 2"x6" WOOD STUDS OR 1⅝"x6" 22 GA. METAL STUDS AT 16" O.C.

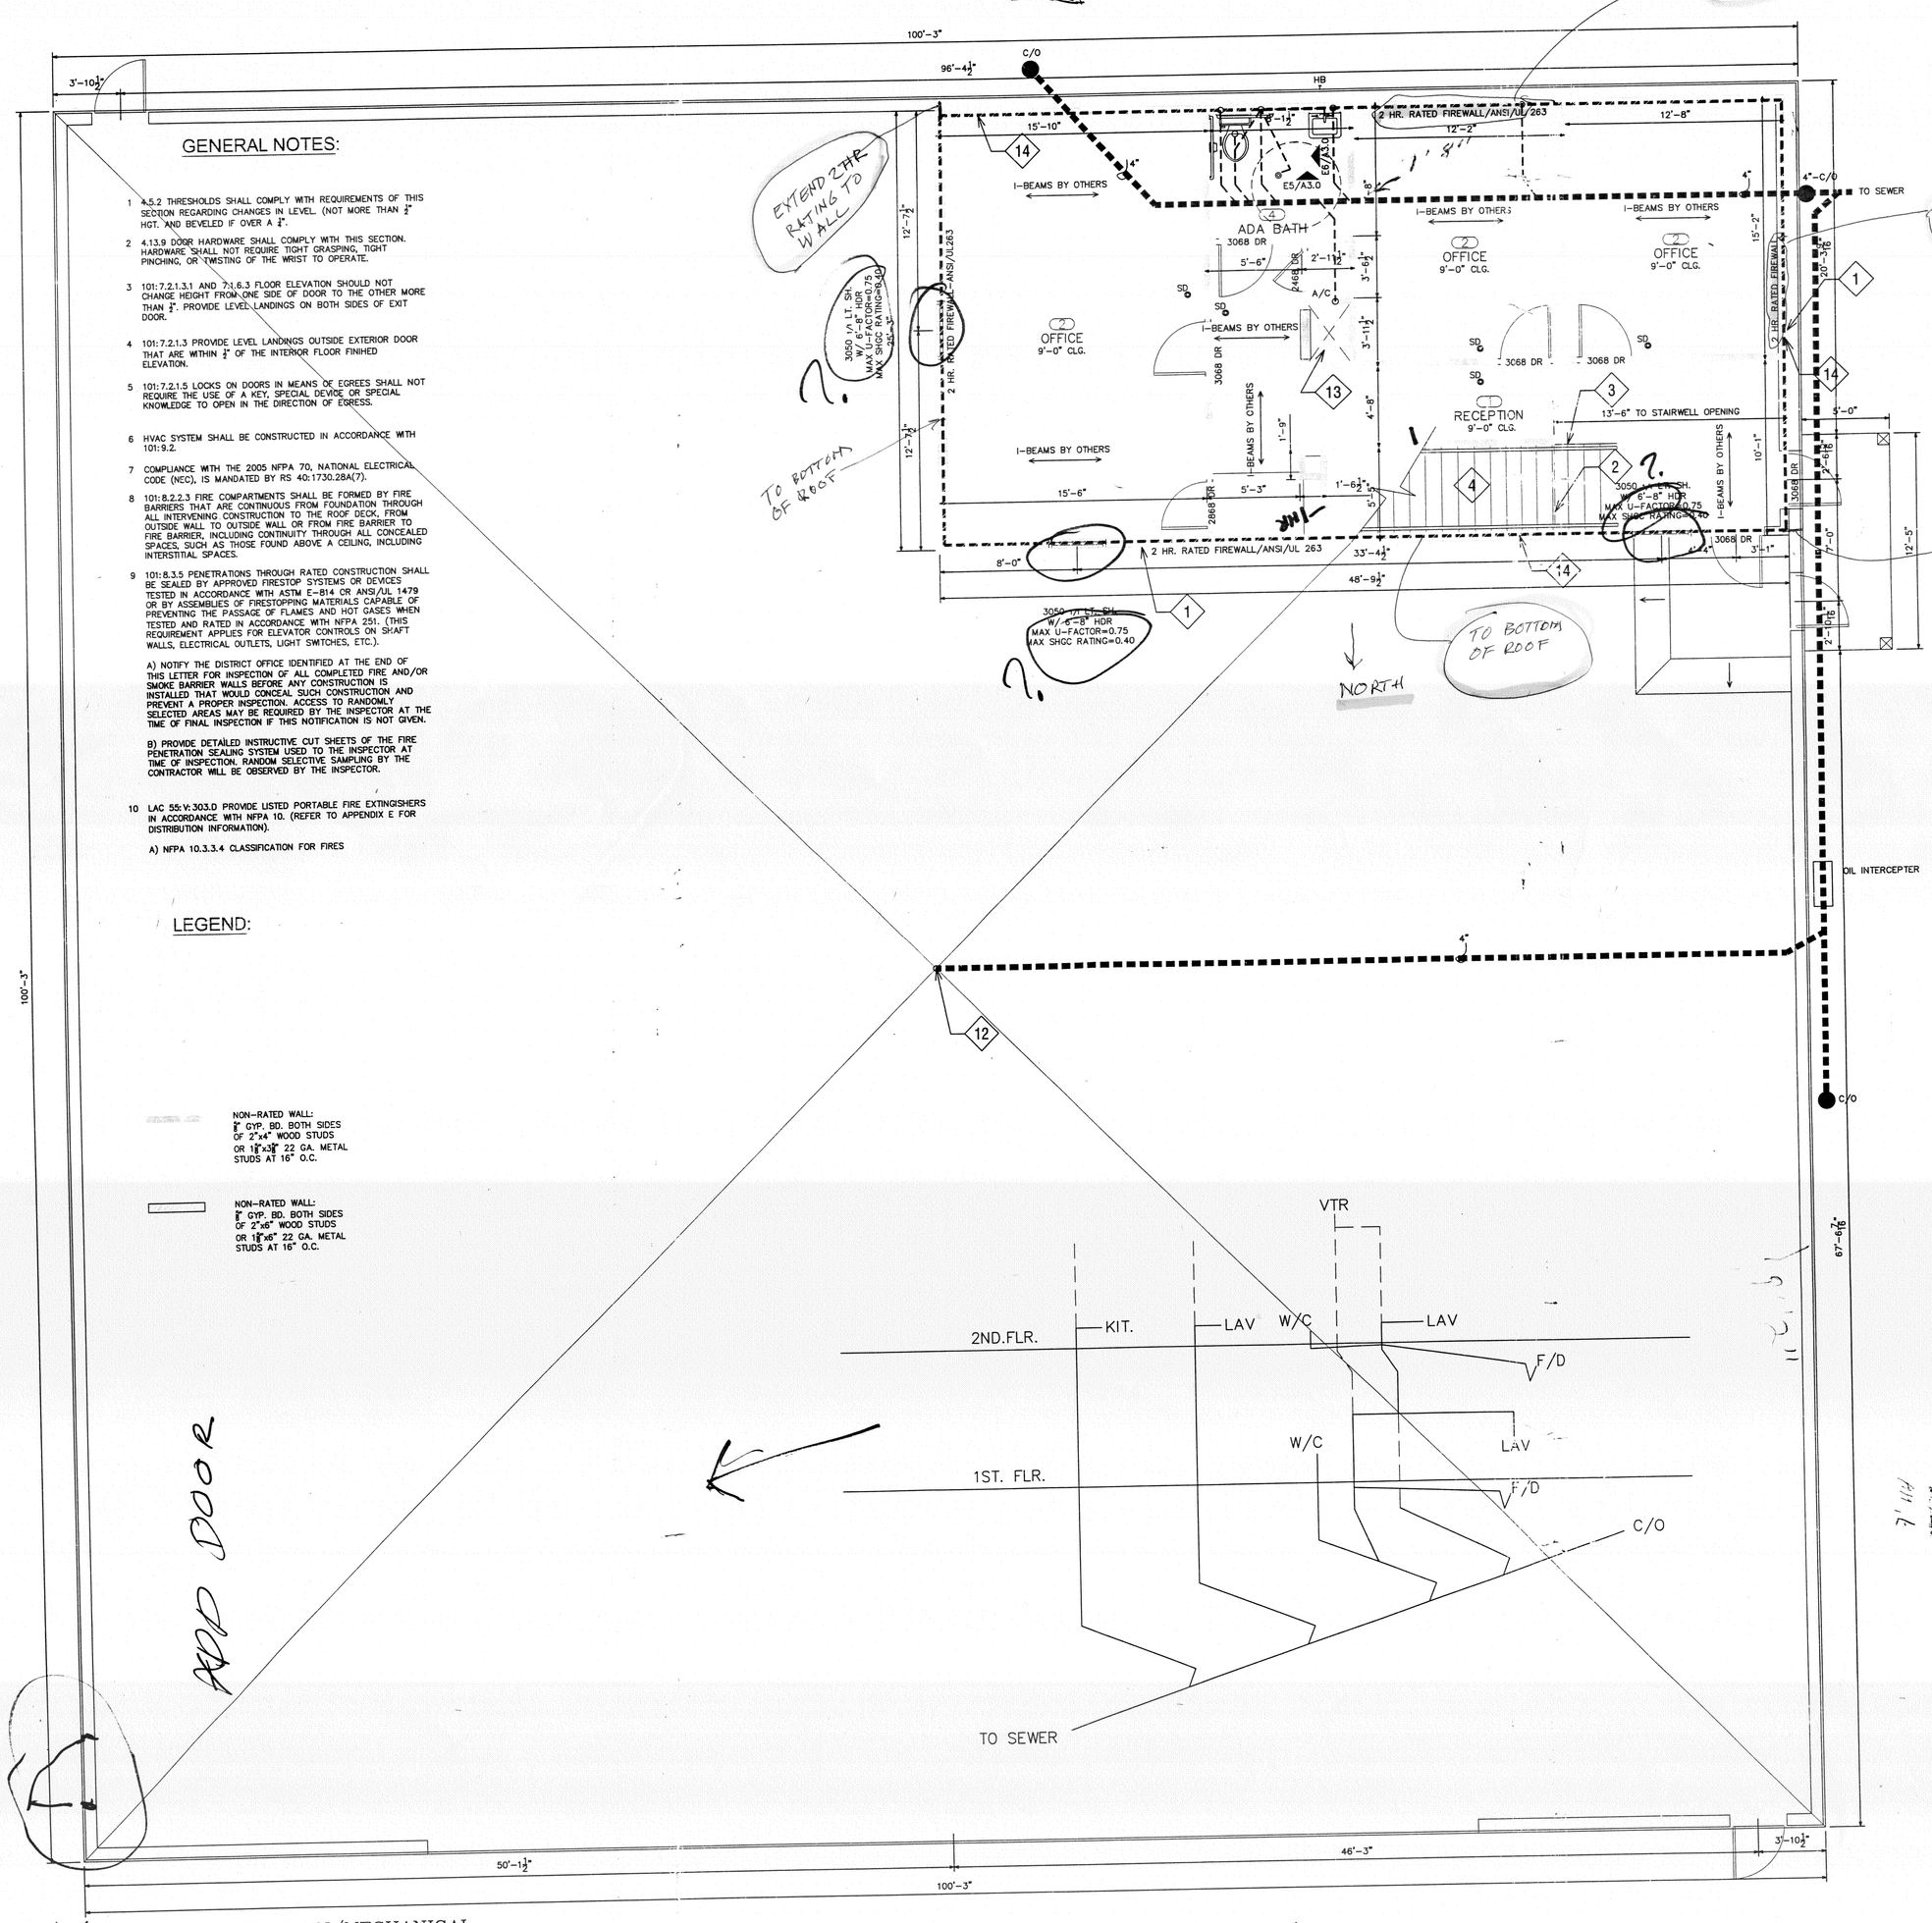

A1 1ST FLR. FLOOR PLAN/MECHANICAL
1/4" = 1'-0"

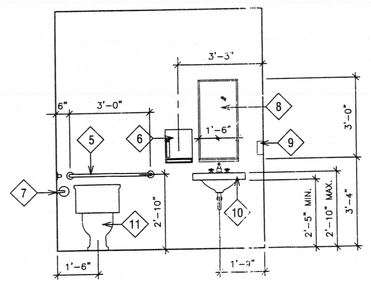

E5 ELEVATION
3/8" = 1' - 0"

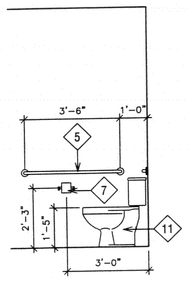

E6 ELEVATION
3/8" = 1' - 0"

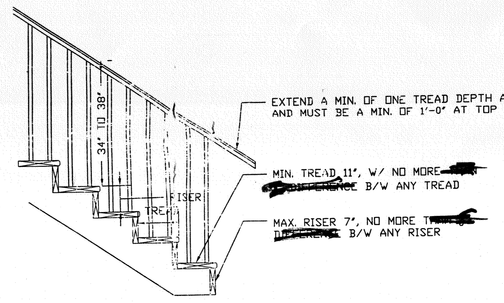

NOTES:
-LANDING AT TOP AND BOTTOM OF ALL STAIRSWAYS EXCEPT, AT TOP OF INTERIOR STAIRWAY, INCLUDING AN ENCLOSED GARAGE. PROVIDED DOOR SWINGS OUT.
-NO VERTICAL RISE IN A STAIRCASE MORE THAN 12'-0" W/O A LANDING
-ALL LANDINGS SHALL BE SAME WIDTH OF STAIRS, AND A MIN. OF 36"
-HANDRAIL IS TO BE CONTINOUSLY GRASPABLE ALONG ENTIRE LENGTH OF RAILING. HANDRAIL IS TO BE 1 ½" TO 2" DIA.
-GUARDRAIL OPENING IS TO HAVE NO LARGER THAN A 4" SPACE BETWEEN RAILING.
-GUARDRAIL SHALL BE AT LEAST 42" HIGH AND ARE REQUIRED WHEN A CHANGE IN ELEVATION EXCEEDS 30".

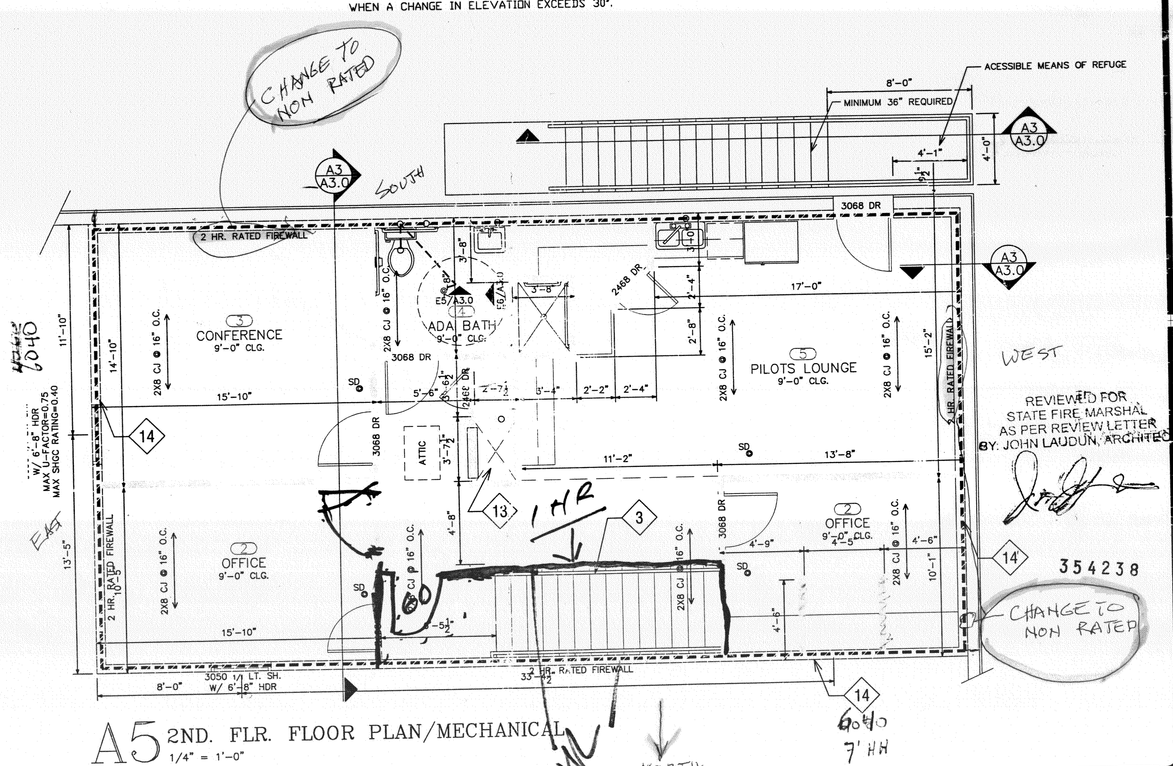

A5 2ND. FLR. FLOOR PLAN/MECHANICAL
1/4" = 1'-0"

DIAMOND DESIGN
Residential Planners
Covington, Louisiana
985-507-4089

SLIDELL MUNICIPAL AIR PORT
FBO CARE SERVICES, LLC
SLIDELL, LA

DRAWN JJB
CHECKED MKB
REVISED JJB

PROJECT

DATE 8/12/2008

SHEET A1.0
OF
QTY