


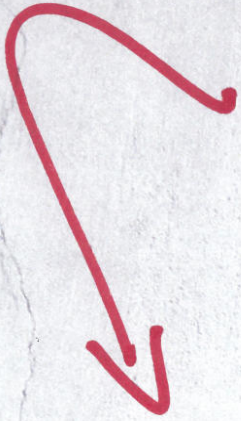

Need C.I.
valve box
set in
concrete.



Need hose bib
in C.I. box.



Pull zip strip,
caulk joint.

